
City of Prince George HISTORY SHEET

0% 10%

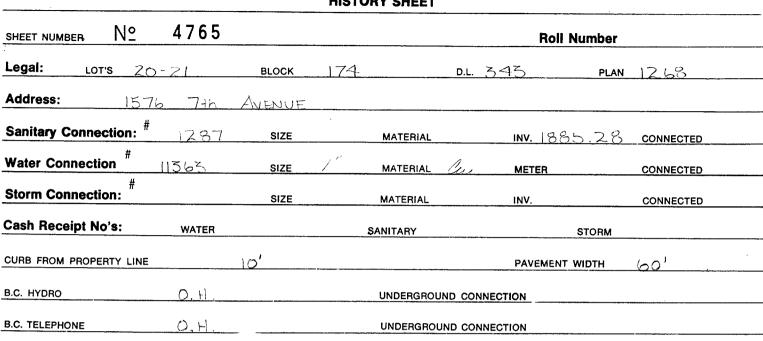

Comments:

BENCH MARK # 40-77 ELEVATION - 1895.03

SIP N.E. CORNER 7th and VANCOUNER.

LANE & 2" MAIN

INLAND GAS

Information Sheets:

