



City of Prince George History Sheet

PID:	012921858
	012921866
SD/MU:	
WO:	

Civic Address: 1721 7th Ave

Legal Description: Lot: 11, 12 Block:179 District Lot: 343 Pla 1268


Service Type	Diameter (mm)	Material	Invert Elev at main (m)	Invert Elev at property line (m)	Invert Elev at service end (m)	Distance into property (m)	Installation Date
Sanitary	100mm	PVC	-	-	-	-	June 2011
Water	20mm	Copper	-	-	-	-	
Storm	N/A	N/A	-	-	-	-	

Service Connection Location					Sanitary (m)	Storm (m)
Distance from downstream San MH			-	towards upstream San MH	-	
Distance from downstream Stm MH			-	towards upstream Stm MH	-	

Power	Size	Communications	Size	Cable	Size	Gas	Size
BC Hydro	-	Telus	-	Shaw	-	FortisBC	-
Overhead Service		Overhead Service		Overhead Service			

Installed by:	Survey Date:	-
Comments: Location of the sanitary service is unknown.		

NOT TO SCALE The information contained herein is for internal use only.
Not to be relied on unless confirmed by site inspection and/or investigation.

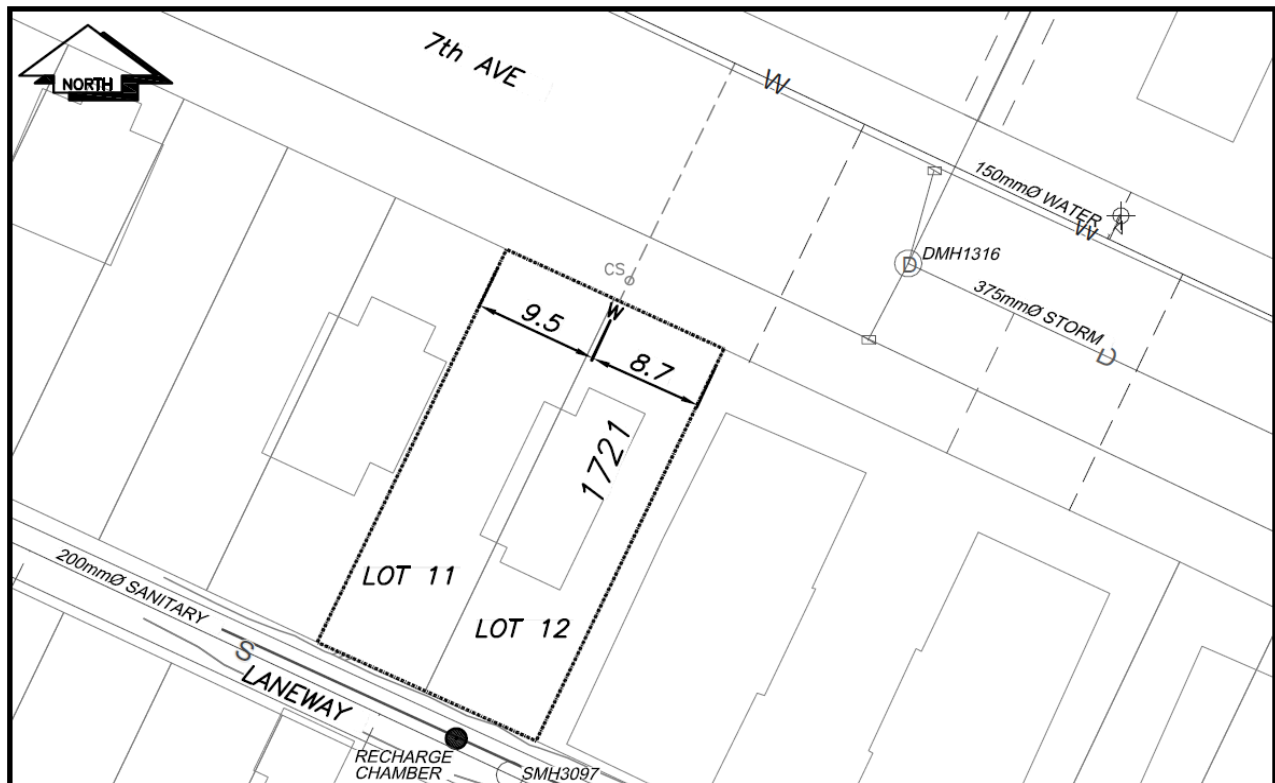

CS	CURB STOP	—	WATER SERVICE	—	STORM SERVICE
CO	CLEAN OUT	- - -	SANITARY SERVICE	—G—	GAS
⊗	WATER VALVE	—	FIRE HYDRANT	- - -	ENCUMBRANCE

NOT TO SCALE