


Lot Servicing

410 BLACKBURN RD N

PID 012933929

Lot: **7**, Plan: **9675**, DL: **957**

SERVICE	SIZE	MATERIAL	INSTALLED DATE	LOCATION	DETAILS
WATER	20MM	CU		SP 2.5M S OF N PL	CASH RECEIPT NUMBER 100574
SANITARY	100MM	PVC			CLEANOUT 1.0M S OF N PL CI-CAP

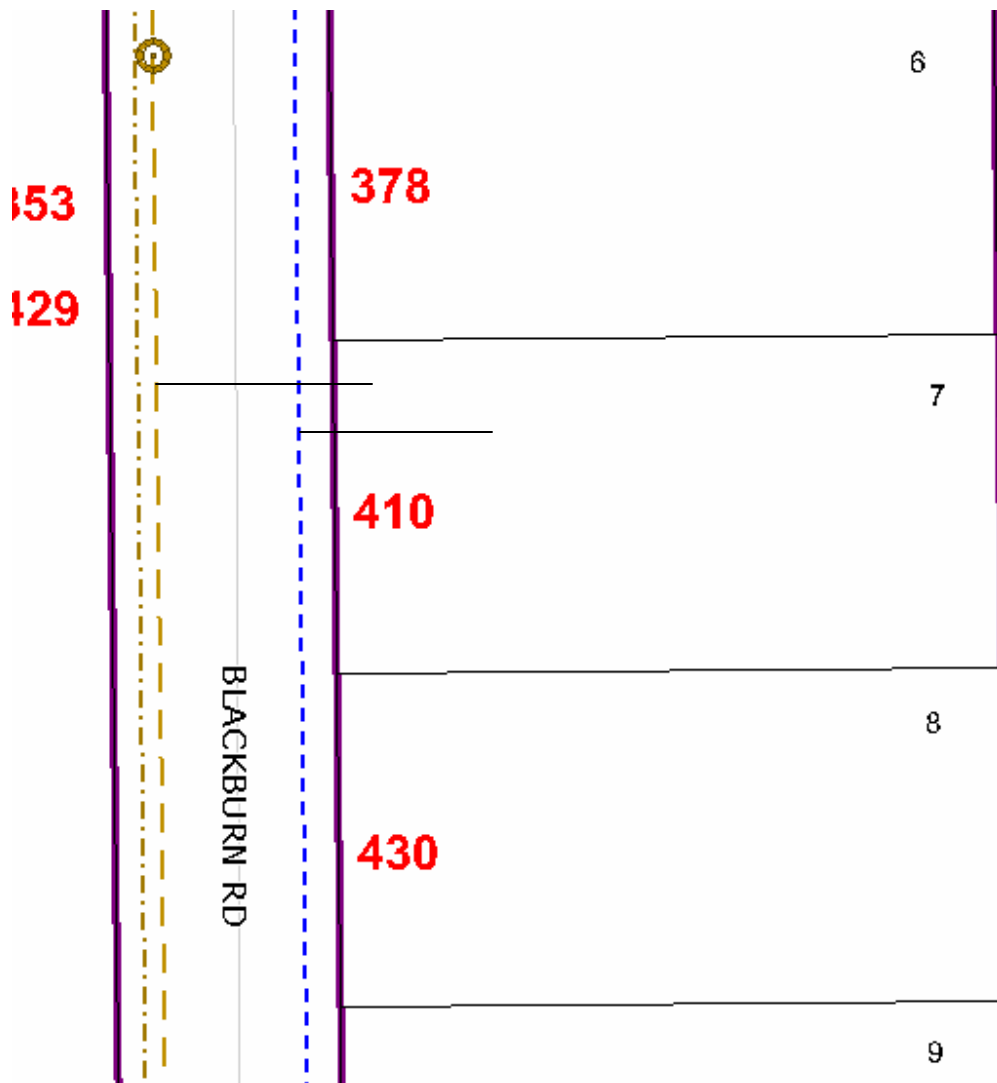

Accuracy not guaranteed unless confirmed by site inspection and/or investigation.
Connection location between main and property line only.