



City of Prince George History Sheet

PID:	012934364
SD/MU:	
WO:	

Civic Address: 1437 Taylor Drive

Legal Description: Lot: 3 District Lot: 343 Plan: 21126


Service Type	Diameter (mm)	Material	Invert Elev at main (m)	Invert Elev at property line (m)	Invert Depth at service end (m)	Distance into property (m)	Installation Date
Sanitary	100mm	AC	574.53	574.74	2.49	-	January 1957
Water	20mm	Copper	-	-	-	-	January 1962
Storm	N/A	N/A	-	-	-	-	

Service Connection Location				Sanitary (m)	Storm (m)
Distance from downstream San MH	4001	towards upstream San MH	795	76.39	
Distance from downstream Stm MH	-	towards upstream Stm MH	-		

Power	Size	Communications	Size	Cable	Size	Gas	Size
BC Hydro	-	Telus	-	Shaw	-	FortisBC	-
Overhead Service		Overhead Service		Overhead Service			

Installed by:	Survey Date:	-
Comments: Water as per September 2015 locate		

NOT TO SCALE The information contained herein is for internal use only.
Not to be relied on unless confirmed by site inspection and/or investigation.

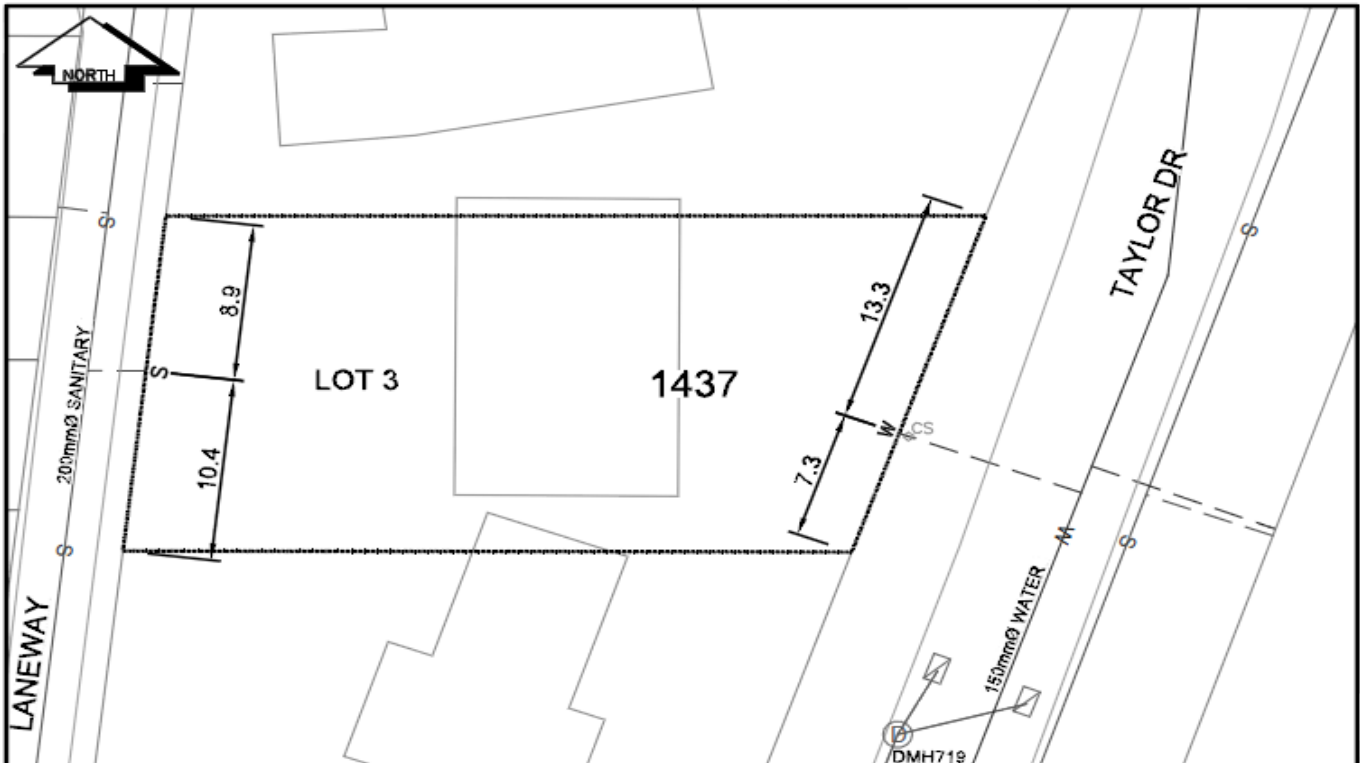

CS CURB STOP	--- M WATER SERVICE	--- S STORM SERVICE
CO CLEAN OUT	--- S SANITARY SERVICE	--- G GAS
WATER VALVE	--- FIRE HYDRANT	--- ENCUMBERANCE

NOT TO SCALE