

031613934

~~012939714~~

City of Prince George  
**History Sheet**

PID:	<del>012939676</del>
MU:	101422
WO:	72690/72691/ 72693

Civic Address: 3939/3961 Austin Rd W

Legal Description: ~~Lot: 9/10 District Lot: 4047 Plan: 9543~~ Parcel F (CA9647815) District Lot 4047 Plan 9543


Service Type	Diameter (mm)	Material	Invert Elev at main (m)	Invert Elev at property line (m)	Invert Elev at service end (m)	Distance into property (m)	Installation Date
Sanitary	200mm	PVC	-	-	-	-	Aug 2013
Water	200mm	PVC	-	-	-	-	Aug 2013
Storm	375mm	PVC	-	-	-	-	Aug 2013

Service Connection Location	Sanitary (m)	Storm (m)
Connected to San MH 387	-	-
Connected to Stm MH 986	-	-

Power	Size	Communications	Size	Cable	Size	Gas	Size
BC Hydro	-	Telus	-	Shaw	-	FortisBC	-
Overhead Service		Overhead Service		Overhead Service			

Installed by:	City of Prince George forces	Survey Date:	-
Comments:			

**NOT TO SCALE** The information contained herein is for internal use only.  
Not to be relied on unless confirmed by site inspection and/or investigation.

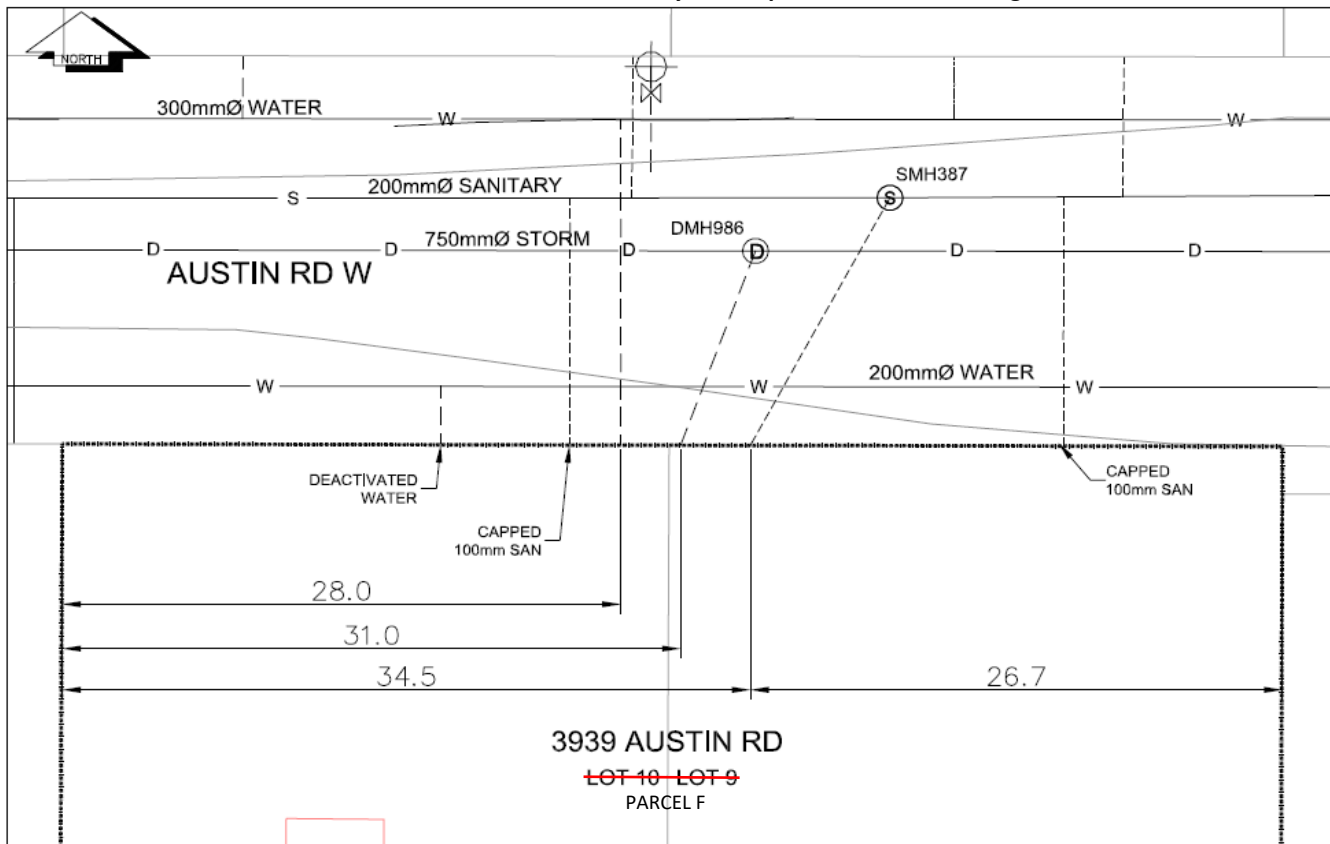

LEGEND:	CS <sup>o</sup> CURB STOP	--- WATER SERVICE	--- STORM SERVICE
	CO <sup>o</sup> CLEAN OUT	--- SANITARY SERVICE	⊗ WATER VALVE

**NOT TO SCALE**