

City of Prince George
HISTORY SHEET

SHEET NUMBER

Roll Number 018942375

Legal: LOT'S 95 BLOCK D.L. 738 PLAN 9101

Address: 2835 Hammond Ave.

Sanitary Connection: # 795 SIZE MATERIAL INV. CONNECTED

Water Connection # 2095 SIZE 20mm MATERIAL COPPER METER CONNECTED

Storm Connection: # SIZE MATERIAL INV. CONNECTED

Cash Receipt No's: WATER SANITARY STORM

CURB FROM PROPERTY LINE PAVEMENT WIDTH

B.C. HYDRO 0/H UNDERGROUND CONNECTION


B.C. TELEPHONE UNDERGROUND CONNECTION

INLAND GAS ON SOUTH SIDE

Information Sheets:

Comments: SANITARY SEWER AND WATER SERVICE CONNECTIONS ARE IN A COMMON TRENCH AND TERMINATE AT MIDPOINT OF EACH LOT. REF. DWG 649

SITE PLAN N.T.S.

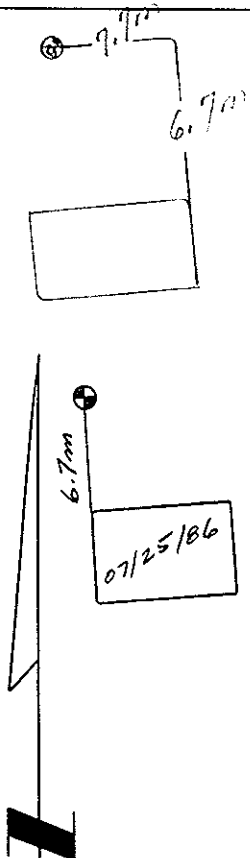

HAMMOND AVE.

