



City of Prince George History Sheet

PID:	012959197
SD/MU:	
WO:	5003738

Civic Address: 1951 3rd Ave

Legal Description: Lot: 15 Block: 126 District Lot: 343 Plan: 1268


Service Type	Diameter (mm)	Material	Invert Elev at main (m)	Invert Elev at property line (m)	Invert Elev at service end (m)	Distance into property (m)	Installation Date
Sanitary	100mm	AC	-	580.70	-	-	January 1957
Water	20mm	Copper	-	-	-	-	June 8, 2016
Storm	N/A	N/A	-	-	-	-	

Service Connection Location				Sanitary (m)	Storm (m)
Distance from downstream San MH	997	towards upstream San MH	996	58.68	
Distance from downstream Stm MH	-	towards upstream Stm MH	-		

Power	Size	Communications	Size	Cable	Size	Gas	Size
BC Hydro	-	Telus	-	Shaw	-	FortisBC	-
Overhead Service		Overhead Service		Overhead Service			

Installed by:	City of Prince George forces	Survey Date:	-
Comments:			

NOT TO SCALE The information contained herein is for internal use only.
Not to be relied on unless confirmed by site inspection and/or investigation.

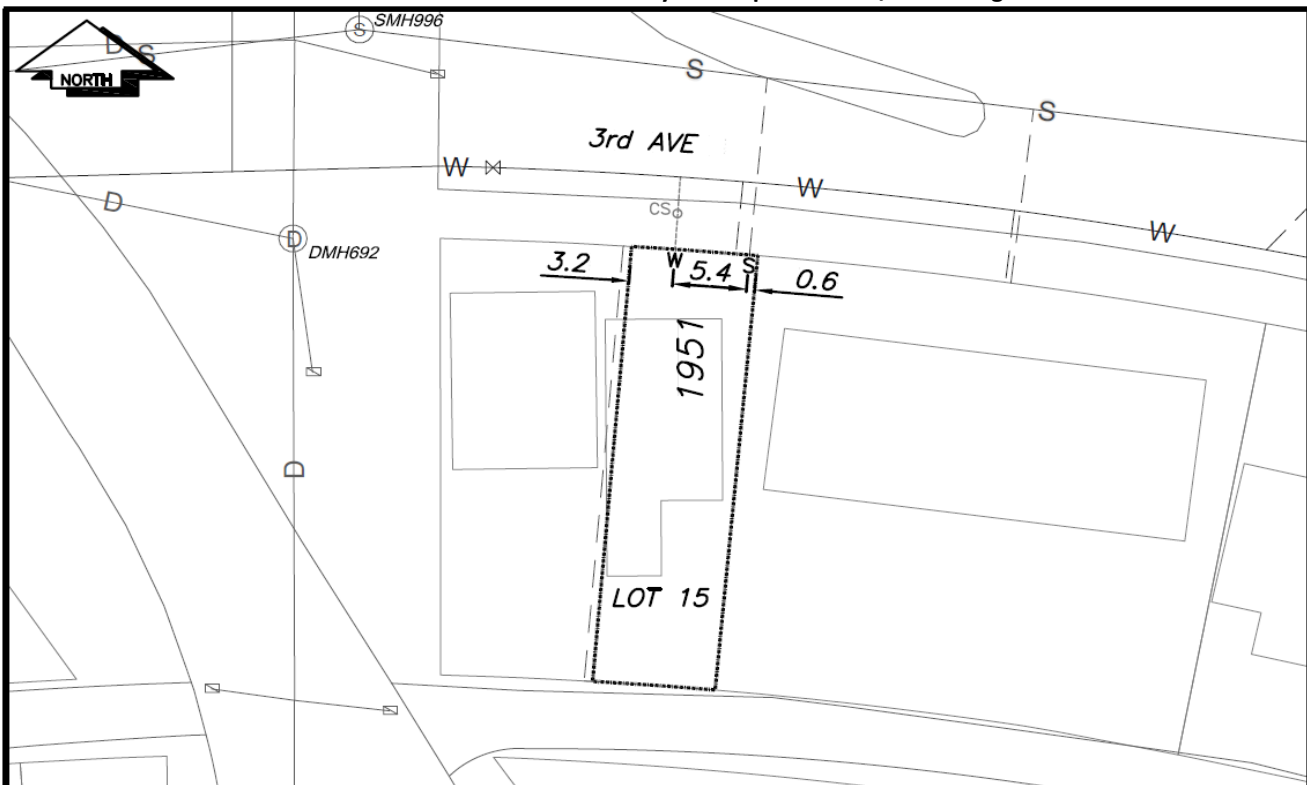

CS	CURB STOP	W	WATER SERVICE	S	STORM SERVICE
CO	CLEAN OUT	- - - - -	SANITARY SERVICE	G	GAS
WV	WATER VALVE	FH	FIRE HYDRANT	- - - - -	ENCUMBRANCE

NOT TO SCALE