



City of Prince George History Sheet

PID:	012968722
MU:	101733
WO:	87671

Civic Address: 1756 8th Avenue

Legal Description: Lot: 18 Block: 1268 District Lot: 343 Plan: 1268


Service Type	Diameter (mm)	Material	Invert Elev at main (m)	Invert Elev at property line (m)	Invert Elev at service end (m)	Distance into property (m)	Installation Date
Sanitary	100mm	PVC	575.08	575.82	575.86	3.20	April 2016
Water	20mm	Copper	574.90	575.39	575.54	3.00	April 2016
Storm	N/A	N/A	-	-	-	-	

Service Connection Location					Sanitary (m)	Storm (m)
Distance from downstream San MH	3099	towards upstream San MH	3086		49.49	
Distance from downstream Stm MH	-	towards upstream Stm MH	-			

Power	Size	Communications	Size	Cable	Size	Gas	Size
BC Hydro	-	Telus	-	Shaw	-	FortisBC	-
Overhead Service		Overhead Service		Overhead Service			

Installed by:	City of Prince George forces	Survey Date:	-
Comments:	Overhead power in laneway		

NOT TO SCALE The information contained herein is for internal use only.
Not to be relied on unless confirmed by site inspection and/or investigation.

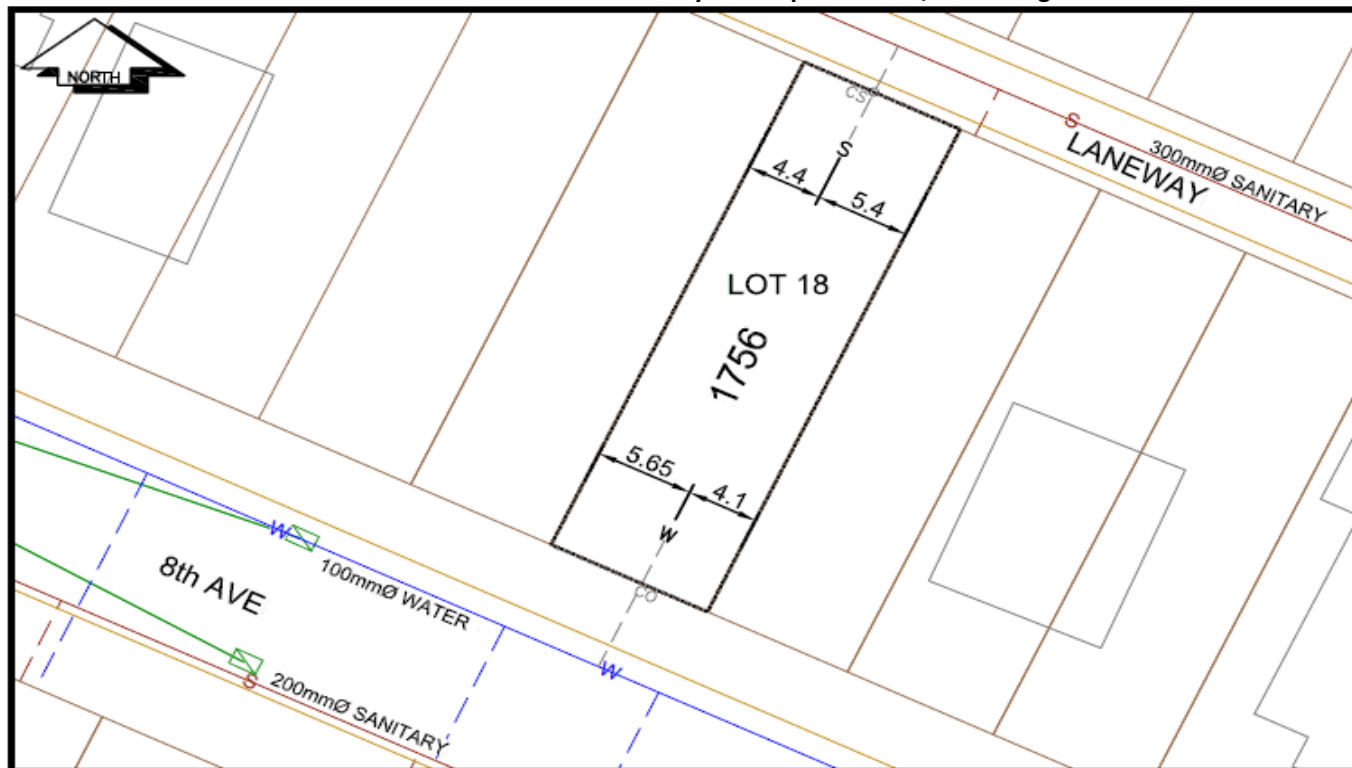

LEGEND:	CS CURB STOP	--- WATER SERVICE	--- STORM SERVICE
	CO CLEAN OUT	-S- SANITARY SERVICE	-G- GAS

NOT TO SCALE