

The information contained herein is for internal use only. Not to be relied upon unless confirmed by site inspection and/or investigation.

City of Prince George  
HISTORY SHEET

012968901  
012968927

SHEET NUMBER	1368		Roll Number	
Legal:	LOT'S 11-12	BLOCK 160	D.L. 343	PLAN 1268
Address:	1613 5 <sup>th</sup> AVE.			
Sanitary Connection:	# 47	SIZE -	MATERIAL -	INV. 1887.33 CONNECTED YES
Water Connection	# 274	SIZE 1/2"	MATERIAL NOT GIVEN	METER - CONNECTED YES
Storm Connection:	# -	SIZE -	MATERIAL -	INV. - CONNECTED -
Cash Receipt No's:	WATER		SANITARY STORM	
CURB FROM PROPERTY LINE	19'		PAVEMENT WIDTH 42'	
B.C. HYDRO	UNDERGROUND CONNECTION EAST SIDE OF VAN. ST.			
B.C. TELEPHONE	UNDERGROUND CONNECTION IN LANE N' OF 6 <sup>th</sup> AVE. WEST SIDE OF VAN. ST.			
INLAND GAS	IN LANE & 2" MAIN			

Information Sheets:

Comments: BENCH MARK # 35-68 ELEVATION = 1900.77  
N.E. CORNER 5<sup>th</sup> AND 'PRINCE ROBERT'  
LEVEL BOOK # 21




## STORM

SANITARY & STORM INVERT CALCULATIONS		DATE	
1. Distance from M.H. <u>21-2</u> to connection point is <u>49'</u> ft. toward M.H.			
2. Calculated invert of main to conn. pt. is	<u>1887.33</u>		
3. Main Size at connection point is <u>8"</u> ins.	<u>.33</u>		
4. Conn. invert at half diameter (Crown) of main is	<u>1887.66</u>		
5. Add to (4) allowance of 0.2 for 1/8 bend. Adjusted invert now	<u>1887.86</u>		
6. Dist. from main to P/L equals _____ ft. at _____ in/ft. gives rise of _____			
7. Item (5) plus (6) equals Calculated Elev. of conn. inv. at P/L equals _____			
13. Elev. of ref. hub top _____			
14. Elev. of invert at P/line _____			
15. Difference or cut below at property line _____	<u>5'-0"</u>		
16. Survey Date _____ 19 <u>56</u> Book Ref. <u>L21 P36</u> by _____			
17. Cut at P/Line in feet and inches _____	<u>5'-0"</u>		

**Sanitary History:**

**Sanitary History:** SEWER HAD ALREADY BEEN LAID FROM HOUSE TO PROPERTY LINE BUT CONTRACTOR WAS UNABLE TO GIVE THE INFORMATION THUS A CONNECTION WAS LEFT AS SHOWN BELOW

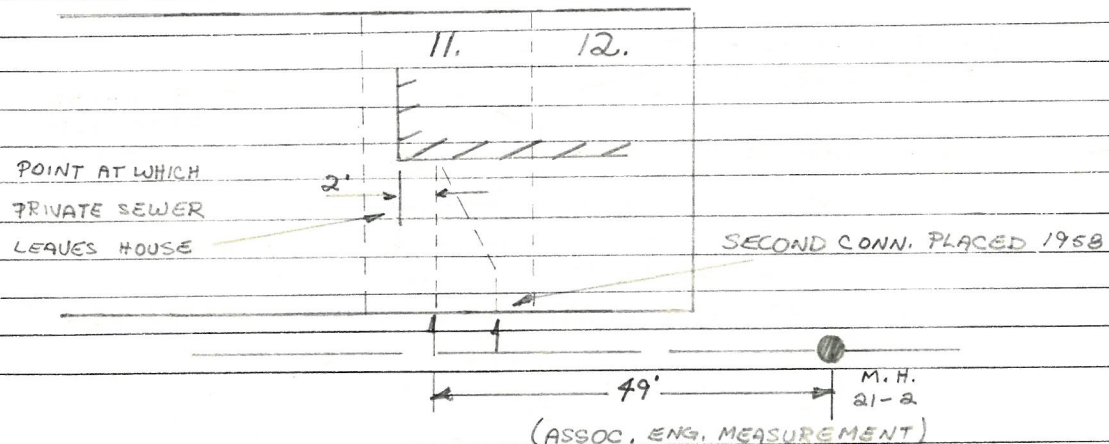

### Water History:

The information contained herein is for internal use only. Not to be relied upon unless confirmed by site inspection and/or investigation.

### Storm History: