

LEGEND:

WATER VALVE

City of Prince George

History Sheet

PID: 012970271 MU: 101609 WO: 84606/84607

ENCUMBERANCE

Civic Address: 1786 6th Ave

Legal Description: Lot: 22 Block:159 District Lot: 343 Plan: 1268


Service Type	Diameter (mm)	Material	Invert Elev at main (m)	Invert Elev at property line (m)	Invert Elev at service end (m)	Distance into property (m)	Installation Date
Sanitary	100mm	PVC	-	-	-	-	August 2015
Water	25mm	Copper	-	-	-	-	August 2015
Storm	N/A	N/A	-	-	-	-	

Service Connection Location	Sanitary (m)	Storm (m)			
Distance from downstream San MH	1999	towards upstream San MH	1996	93.12	
Distance from downstream Stm MH	-	towards upstream Stm MH	-		

Power	Size	Communications	Size	Cable	Size	Gas	Size
BC Hydro	-	Telus	-	Shaw	-	FortisBC	-
Overhead Service		Overhead Service		Overhead Service			

Installed by:	City of Prince George forces	Survey Date:	-
Comments:			

NOT TO SCALE The information contained herein is for internal use only. Not to be relied on unless confirmed by site inspection and/or investigation.

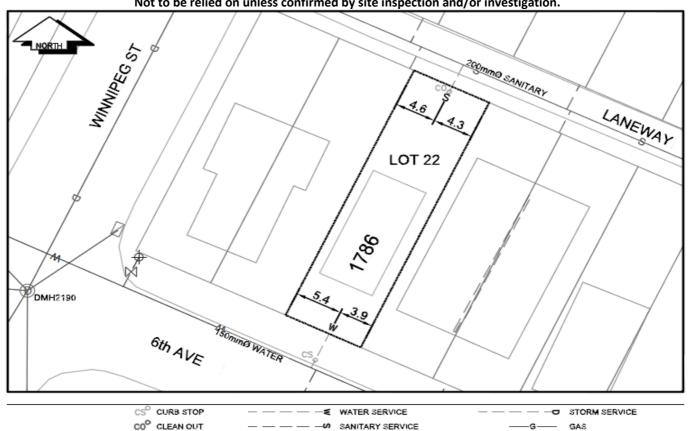

FIRE HYDRANT