



# City of Prince George History Sheet

PID:	013075675
	013075691
	013075730
SD/MU:	
WO:	

Civic Address: 1957 Ross Cres

Legal Description: Lot: 22 - 24 Block: 123 District Lot: 343 Plan: 1268 except PCL A Plan B6605)


Service Type	Diameter (mm)	Material	Invert Elev at main (m)	Invert Elev at property line (m)	Invert Depth at service end (m)	Distance into property (m)	Installation Date
Sanitary	100mm	AC	-	578.88	2.07	-	December 1956
Water	20mm	Copper	-	-	-	-	December 1961
Storm	N/A	N/A	-	-	-	-	

Service Connection Location				Sanitary (m)	Storm (m)
Distance from downstream San MH	2693	towards upstream San MH	2690	51.24	
Distance from downstream Stm MH	-	towards upstream Stm MH	-		

Power	Size	Communications	Size	Cable	Size	Gas	Size
BC Hydro	-	Telus	-	Shaw	-	FortisBC	-
Overhead Service		Overhead Service		Overhead Service			

Installed by:	Survey Date:	-
Comments:		

**NOT TO SCALE** The information contained herein is for internal use only.  
Not to be relied on unless confirmed by site inspection and/or investigation.

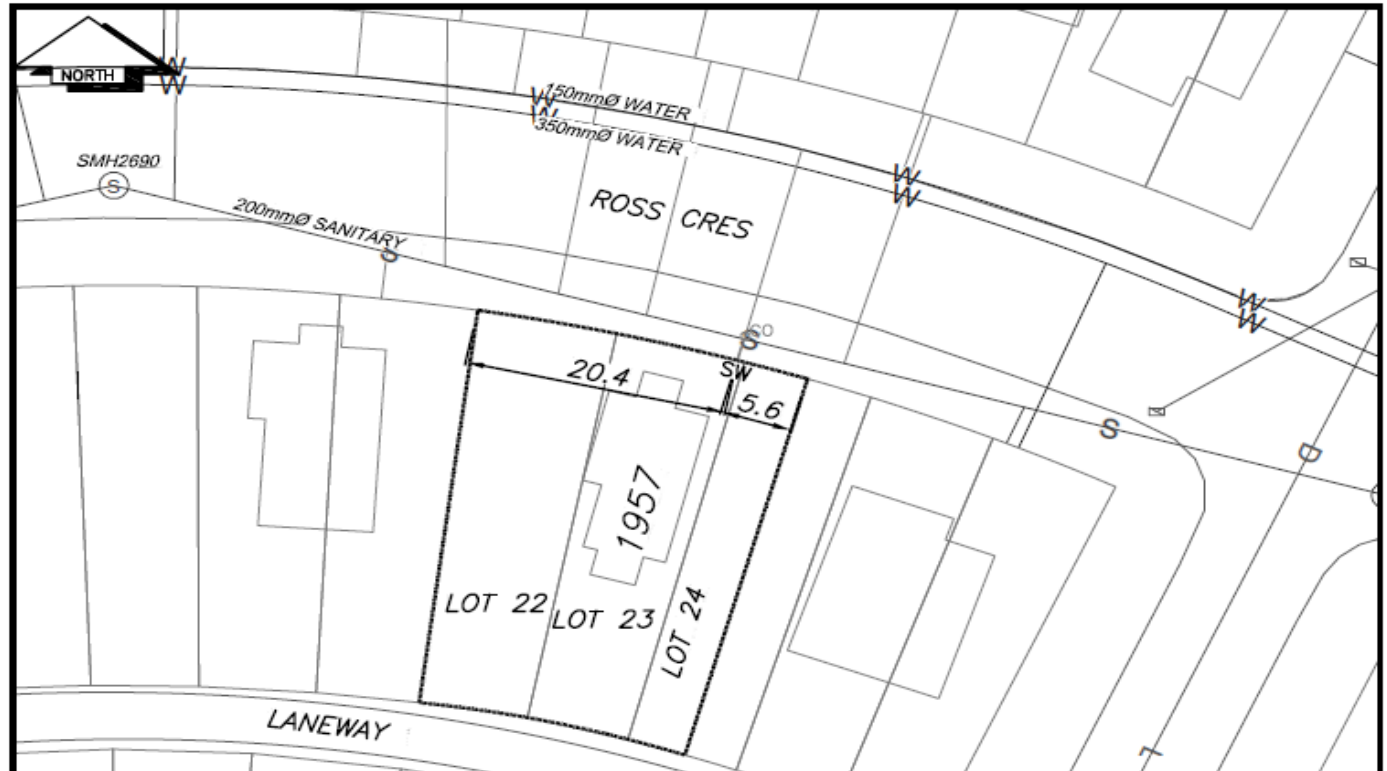

CS <sup>o</sup> CURB STOP	— W — WATER SERVICE	— S — STORM SERVICE
CO <sup>o</sup> CLEAN OUT	- - - - - S SANITARY SERVICE	— G — GAS
⊗ WATER VALVE	⊗ FIRE HYDRANT	- - - - - ENCUMBERANCE

**NOT TO SCALE**