



City of Prince George History Sheet

PID:	013075781
	013075802
SD/MU:	
WO:	

Civic Address: 301 George St
1119 3rd Ave

Legal Description: Lot: 1, 2 Block: 134 District Lot: 343 Plan: 1268


Service Type	Diameter (mm)	Material	Invert Elev at main (m)	Invert Elev at property line (m)	Invert Elev at service end (m)	Distance into property (m)	Installation Date
Sanitary	Unknown	Unknown	-	-	-	-	January 1984
Water	Unknown	Unknown	-	-	-	-	January 1957
Storm	N/A	N/A	-	-	-	-	

Service Connection Location					Sanitary (m)	Storm (m)
Distance from downstream San MH	2020	towards upstream San MH	3121		82.66	
Distance from downstream Stm MH	-	towards upstream Stm MH	-			

Power	Size	Communications	Size	Cable	Size	Gas	Size
BC Hydro	-	Telus	-	Shaw	-	FortisBC	-
Overhead Service		Overhead Service		Overhead Service			

Installed by:	Survey Date:	-
Comments:		

NOT TO SCALE The information contained herein is for internal use only.
Not to be relied on unless confirmed by site inspection and/or investigation.

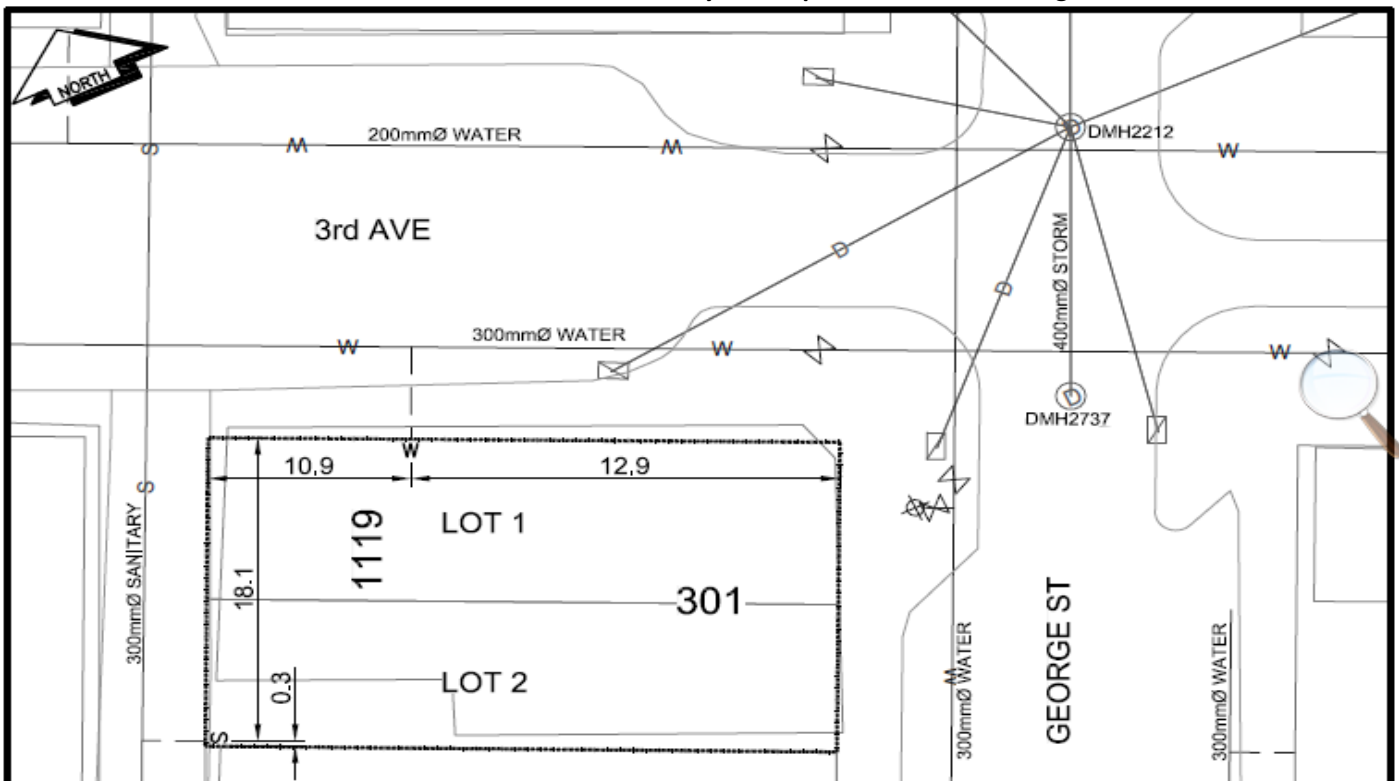

CS ^o	CURB STOP	---	W	WATER SERVICE	---	o	STORM SERVICE
CO ^o	CLEAN OUT	---	S	SANITARY SERVICE	---	G	GAS
X	WATER VALVE	---	+	FIRE HYDRANT	---	---	ENCUMBRANCE

NOT TO SCALE