


Lot Servicing

1680 BURDEN ST

PID: 013086421;013086456;013086821

Lot: 12,13 & F Block: 110, Plan: 1268, DL: 343

SERVICE	SIZE	MATERIAL	INSTALLED DATE	LOCATION	DETAILS
WATER	20MM	CU	31-Oct-1961	FR W CR BLD 8.229M NW 5.486M NE	CONNECTION NUMBER 3162
WATER	40MM	UNKNOWN	04-Jun-2007	NO LOCATION	CASH RECEIPT NUMBER MU100703
SANITARY	UNKNOWN	UNKNOWN		10.668M N OF SW CR PL	CONNECTION # 3011

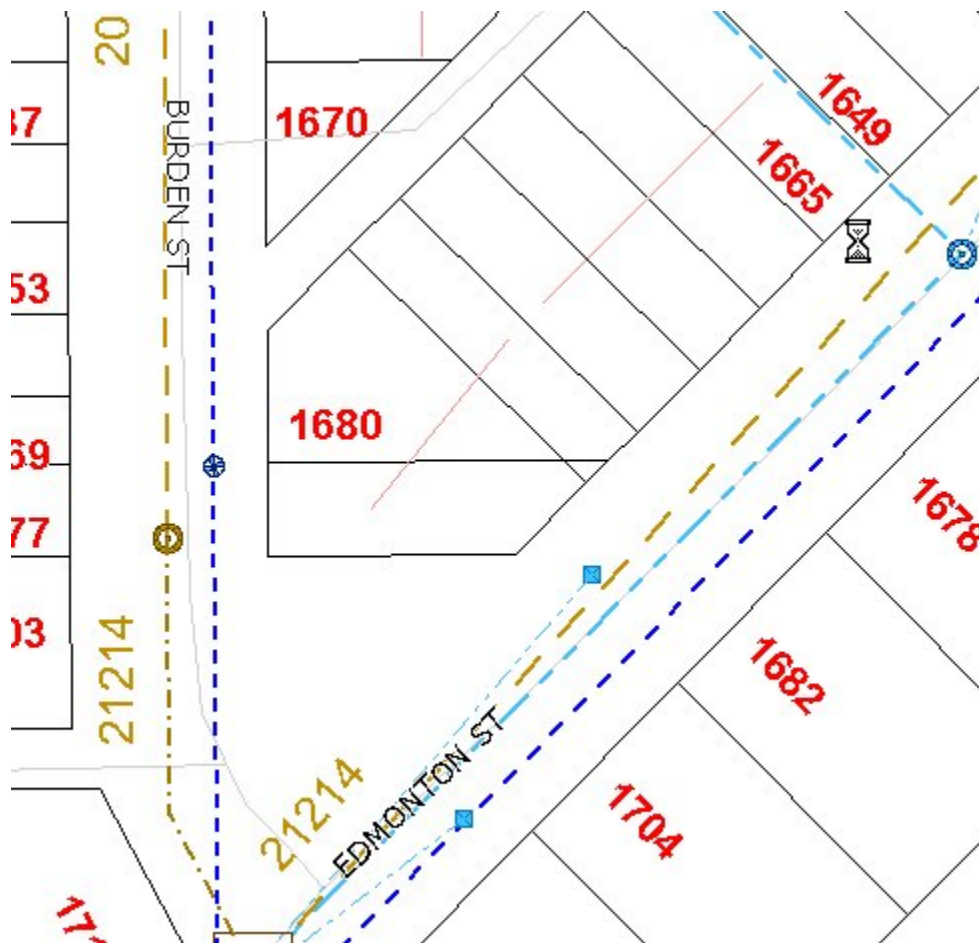

Accuracy not guaranteed unless confirmed by site inspection and/or investigation.
Connection location between main and property line only.

