



# City of Prince George History Sheet

PID:	013122011
SD/MU:	
WO:	

Civic Address: 2580 Ross Cres

Legal Description: Lot: 15 Block: 115 District Lot: 343 Plan: 1268


Service Type	Diameter (mm)	Material	Invert Elev at main (m)	Invert Elev at property line (m)	Invert Depth at service end (m)	Distance into property (m)	Installation Date
Sanitary	100mm	PVC	580.44	581.04	2.64	-	December 1956
Water	20mm	Copper	-	-	-	-	December 1956
Storm	N/A	N/A	-	-	-	-	

Service Connection Location					Sanitary (m)	Storm (m)
Distance from downstream San MH	-	towards upstream San MH	-	-	-	
Distance from downstream Stm MH	-	towards upstream Stm MH	-	-		

Power	Size	Communications	Size	Cable	Size	Gas	Size
BC Hydro	-	Telus	-	Shaw	-	FortisBC	-
Overhead Service		Overhead Service		Overhead Service			

Installed by:		Survey Date:	-
Comments:	Water And Sanitary services located August 03, 2018		

**NOT TO SCALE** The information contained herein is for internal use only.  
Not to be relied on unless confirmed by site inspection and/or investigation.

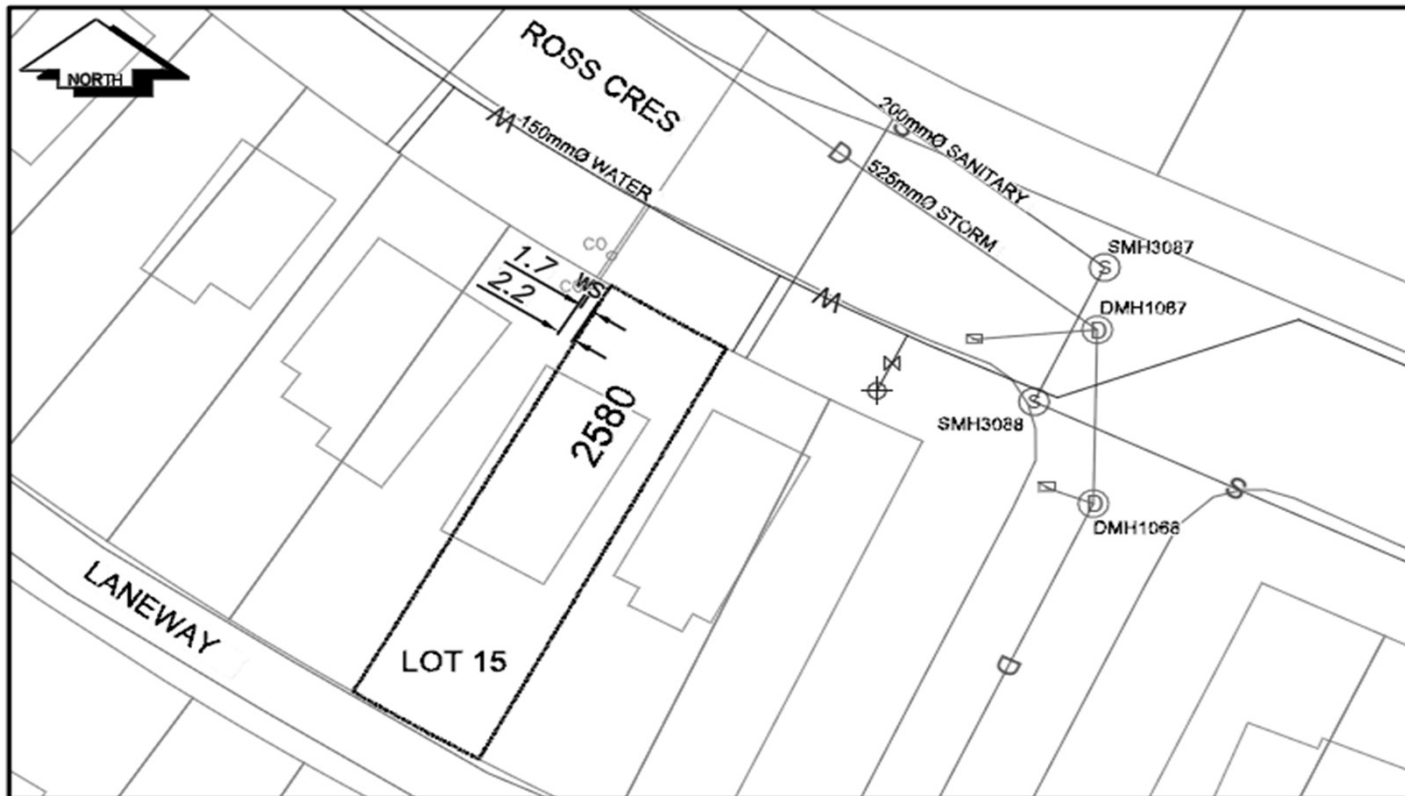

CS	CURB STOP	—	WATER SERVICE	—	STORM SERVICE
CO	CLEAN OUT	- - - -	SANITARY SERVICE	—G—	GAS
⊗	WATER VALVE	⊗	FIRE HYDRANT	- - - -	ENCUMBRANCE

**NOT TO SCALE**