


City of Prince George HISTORY SHEET

313122301
312

SHEET NUMBER		N ^o 2287		Roll Number	
Legal:	LOT'S	9-10	BLOCK	6	D.L. 937 PLAN 752
Address: 731 HARPER STREET					
Sanitary Connection:	#	4371	SIZE	100mm	MATERIAL ACS INV. CONNECTED
Water Connection	#	950	SIZE	13mm	MATERIAL METER CONNECTED
Storm Connection:	#		SIZE		MATERIAL INV. CONNECTED
Cash Receipt No's: WATER SANITARY STORM					
CURB FROM PROPERTY LINE		4.877m		PAVEMENT WIDTH	
B.C. HYDRO	OVERHEAD		UNDERGROUND CONNECTION		
B.C. TELEPHONE	OVERHEAD		UNDERGROUND CONNECTION		
INLAND GAS					
Information Sheets:					
Comments:					

SITE PLAN N.T.S.

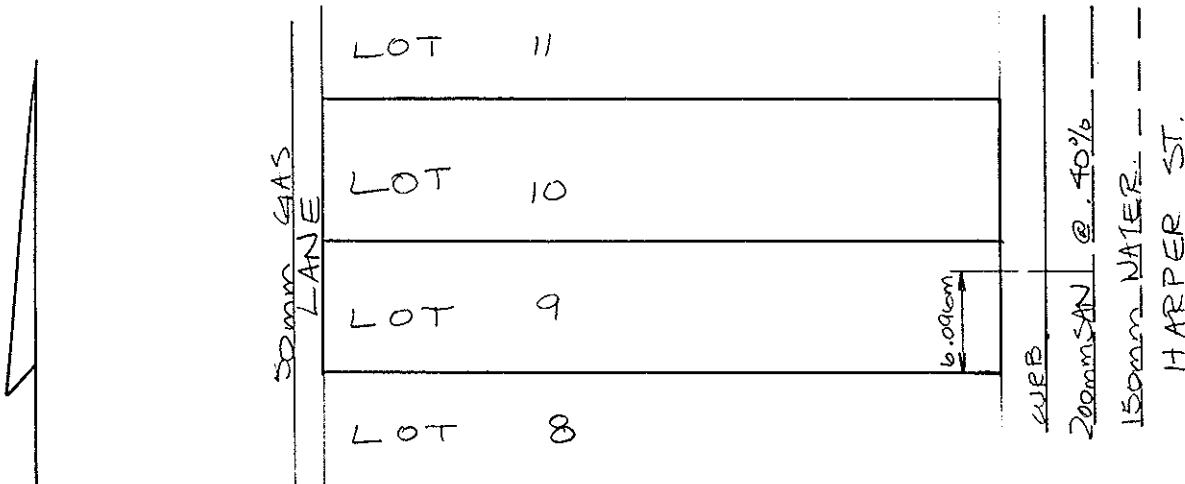


REPORT TO RECORDS

WATER SERVICE INFORMATION

Lot No. _____ Block _____ D.L. _____

Address 731 Harper.Size of Connection ☐ 1/2" ☐ 3/4" ☐ Other _____Type of Connection ☐ Copper ☐ IronThaw Wire ☐ Yes ☐ No

LOCATION SKETCH

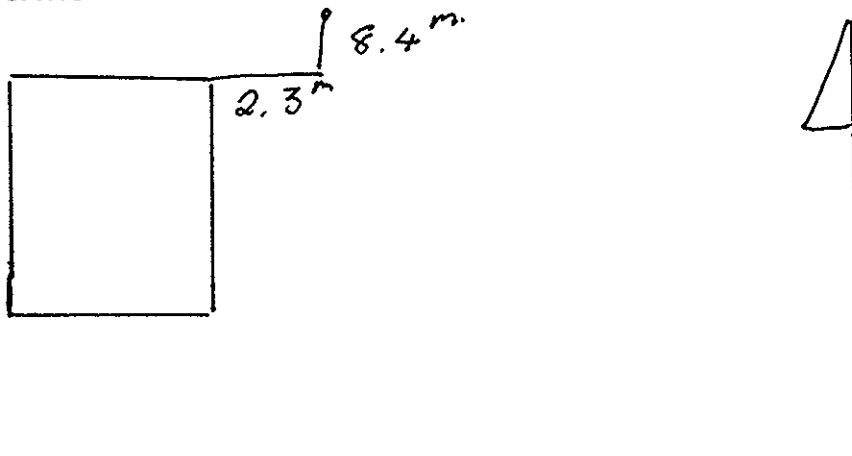Field Location By G.C. Date 11/6/92.

Checked by: _____