



# City of Prince George History Sheet

PID:	013138375
	013138383
SD/MU:	
WO:	5013539

Civic Address: 1323 Alward St

Legal Description: Lot: 3, 4 Block: 99 District Lot: 343 Plan: 1268


Service Type	Diameter (mm)	Material	Invert Elev at main (m)	Invert Elev at property line (m)	Invert Elev at service end (m)	Distance into property (m)	Installation Date
Sanitary	100mm	Vit	585.71	585.78	-	-	January 1957
Water	20mm	Copper	-	-	-	-	January 1957
Storm	N/A	N/A	-	-	-	-	

Service Connection Location				Sanitary (m)	Storm (m)
Distance from downstream San MH	2843	towards upstream San MH	741	47.92	
Distance from downstream Stm MH	-	towards upstream Stm MH	-		

Power	Size	Communications	Size	Cable	Size	Gas	Size
BC Hydro	-	Telus	-	Shaw	-	FortisBC	-
Overhead Service		Overhead Service		Overhead Service			

Installed by:	Maintenance performed on sanitary service July 2019	Survey Date:	-
Comments:			

**NOT TO SCALE** The information contained herein is for internal use only.  
Not to be relied on unless confirmed by site inspection and/or investigation.

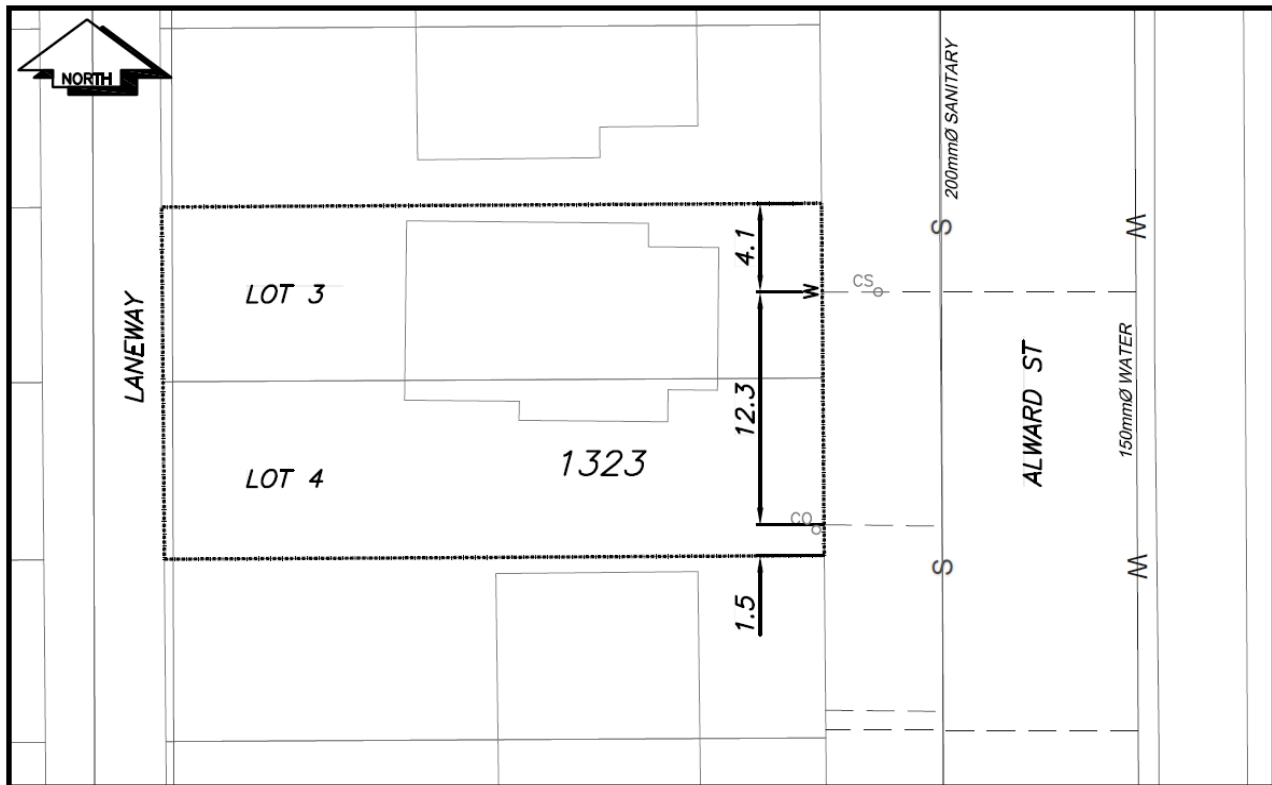

CS	CURB STOP	—W—	WATER SERVICE	—S—	SANITARY SERVICE	—G—	GAS	—D—	STORM SERVICE
CO	CLEAN OUT	---	ENCUMBRANCE	—F—	FIRE HYDRANT				
⊗	WATER VALVE								

**NOT TO SCALE**