



City of Prince George History Sheet

PID:	013168037
SD/MU:	
WO:	

Civic Address: 2723 - 2725 Range Rd

Legal Description: Lot: 3 District Lot: 8182 Plan: 8714


Service Type	Diameter (mm)	Material	Invert Elev at main (m)	Depth of cut at property line (m)	Invert Elev at service end (m)	Distance into property (m)	Installation Date
Sanitary	100mm	AC	-	2.47	-	-	September 1977
Sanitary	100mm	PVC	-	-	-	-	September 2012
Water	20mm	Copper	-	-	-	-	January 19977
Water	20mm	Copper	-	-	-	-	September 2012
Storm	N/A	N/A	-	-	-	-	

Service Connection Location				Sanitary (m)	Storm (m)
Distance from downstream San MH	4108	towards upstream San MH	4109	55.20	
Distance from downstream San MH	4108	towards upstream San MH	4109	66.70	
Distance from downstream Stm MH	-	towards upstream Stm MH	-		

Power	Size	Communications	Size	Cable	Size	Gas	Size
BC Hydro	-	Telus	-	Shaw	-	FortisBC	-
Overhead Service		Overhead Service		Overhead Service			

Installed by:	City of Prince George forces	Survey Date:	-
Comments:			

NOT TO SCALE The information contained herein is for internal use only.
Not to be relied on unless confirmed by site inspection and/or investigation.

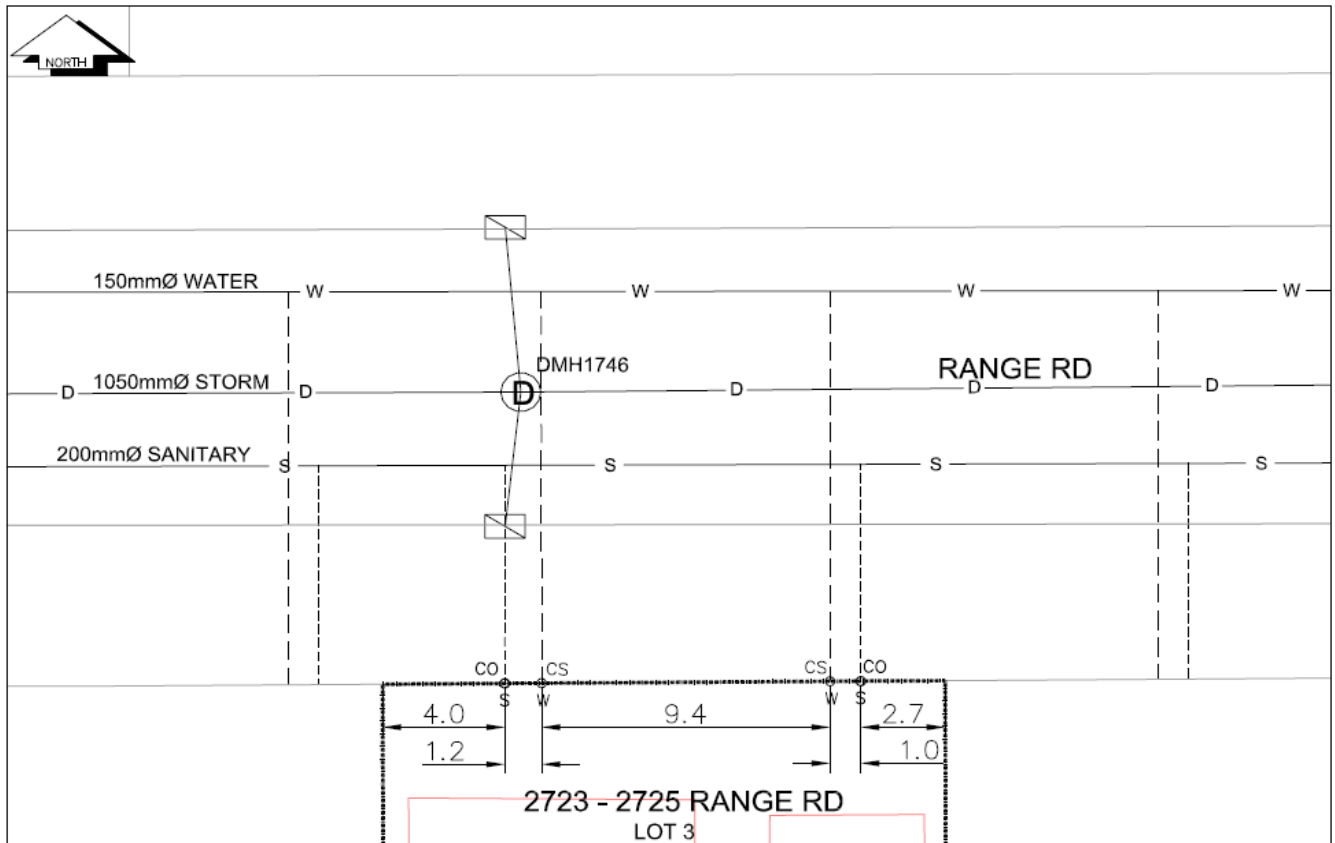

LEGEND:	CS ^o CURB STOP	--- WATER SERVICE	--- STORM SERVICE
	CO ^o CLEAN OUT	--- SANITARY SERVICE	⊗ WATER VALVE

NOT TO SCALE