
## Lot Servicing

## 2147 8TH AVE Lot: 28, Block: 78, Plan: 1268, DL: 343

PID: 013197916

SERVICE	SIZE	MATERIAL	INSTALLED DATE	LOCATION	DETAILS
WATER	20MM	CU	30-Jul-2007	7.2M E OF W PL	CASH RECEIPT NUMBER 100744
SANITARY	100MM	PVC	30-Jul-2007	7.5M E OF W PL	CLEANOUT 7.6M W OF E PL

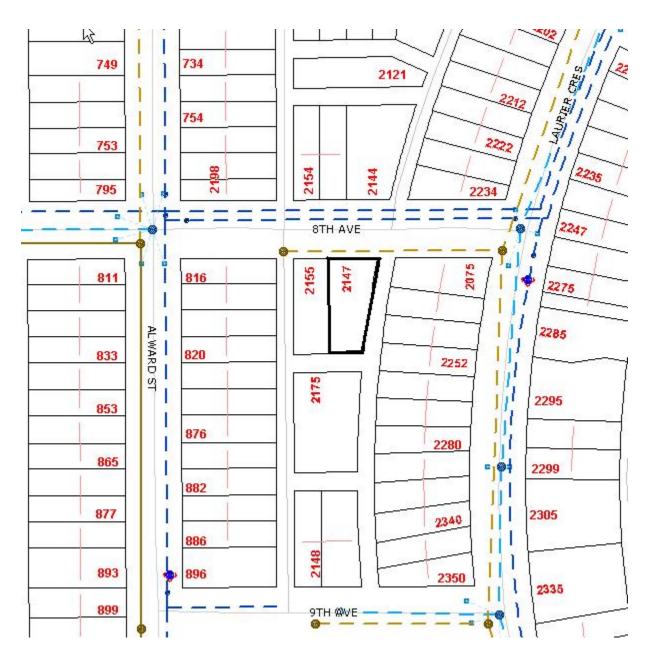

Accuracy not guaranteed unless confirmed by site inspection and/or investigation. Connection location between main and property line only.