



City of Prince George History Sheet

PID:	013200569
SD/MU:	
WO:	

Civic Address: 552 Beech Cres

Legal Description: Lot: 6 Block: 5 District Lot: 8178 Plan: 17368


Service Type	Diameter (mm)	Material	Invert Elev at main (m)	Invert Elev at property line (m)	Invert Elev at service end (m)	Distance into property (m)	Installation Date
Sanitary	100mm	Vit	-	-	-	-	December 1967
Water	20mm	Copper	-	-	-	-	December 1965
Storm	N/A	N/A	-	-	-	-	

Service Connection Location				Sanitary (m)	Storm (m)
Distance from downstream San MH	1795	towards upstream San MH	1827	42.86	
Distance from downstream Stm MH	-	towards upstream Stm MH	-		

Power	Size	Communications	Size	Cable	Size	Gas	Size
BC Hydro	-	Telus	-	Shaw	-	FortisBC	-
Underground Service		Underground Service		Underground Service			

Installed by:	-	Survey Date:	-
Comments:			

NOT TO SCALE The information contained herein is for internal use only.
Not to be relied on unless confirmed by site inspection and/or investigation.

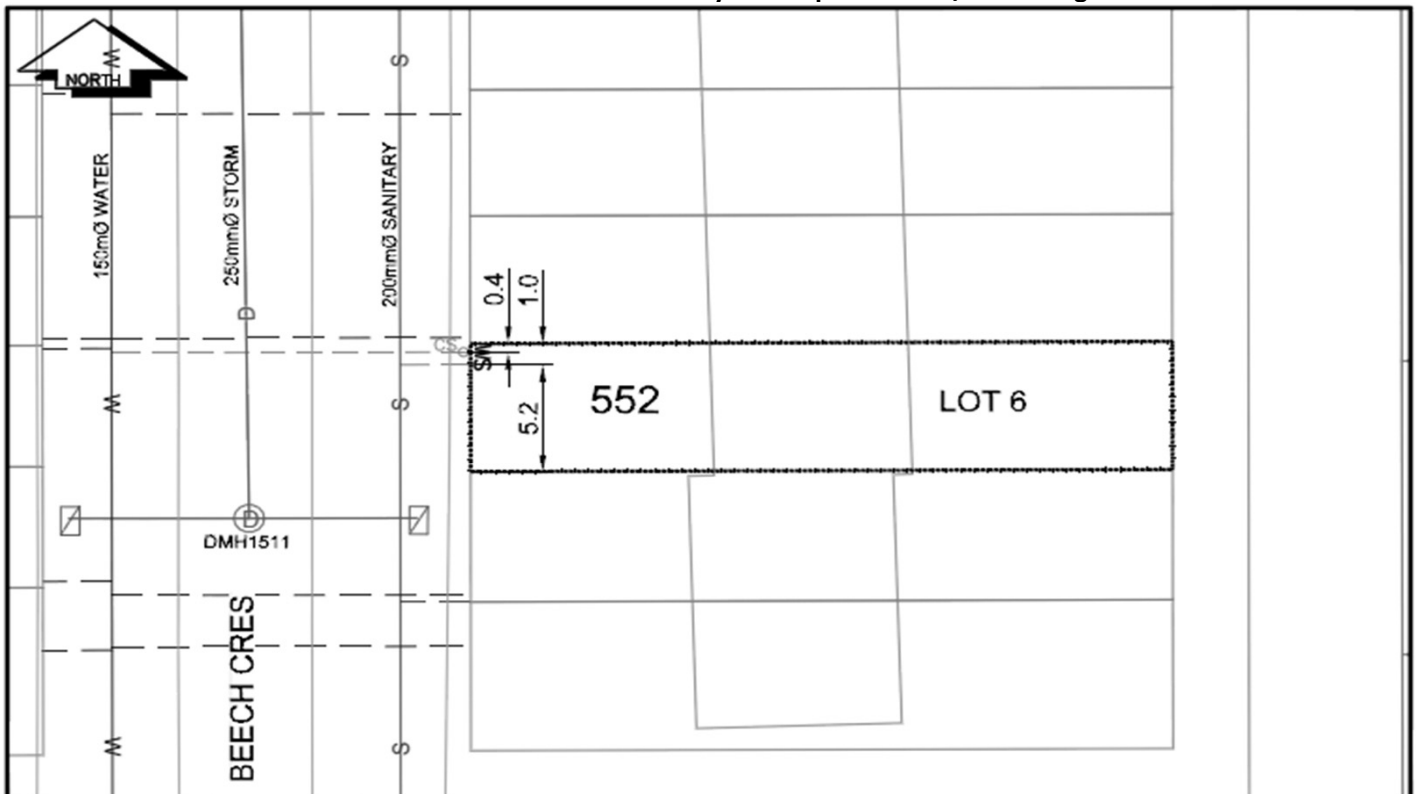

LEGEND:	CS° CURB STOP	--- WATER SERVICE	--- STORM SERVICE
	CO° CLEAN OUT	--- SANITARY SERVICE	--- GAS
	⊗ WATER VALVE	⊗ FIRE HYDRANT	--- ENCUMBRANCE

NOT TO SCALE