



City of Prince George
History Sheet

PID:	013216040
MU:	102257
WO:	103681

Civic Address: 2432 North Nechako Rd

Legal Description: Lot: B District Lot: 7634 Plan: 19040


Service Type	Diameter (mm)	Material	Invert Elev at main (m)	Invert Elev at property line (m)	Invert Elev at service end (m)	Distance into property (m)	Installation Date
Sanitary	100mm	PVC	600.64	604.34	-	-	September 2020
Water	20mm	Copper	-	-	-	-	December 1971
Storm	N/A	N/A	-	-	-	-	

Service Connection Location	Sanitary (m)	Storm (m)
100mm Sanitary service connected to San MH1509	-	
Distance from downstream Stm MH - towards upstream Stm MH -		

Power	Size	Communications	Size	Cable	Size	Gas	Size
BC Hydro	-	Telus	-	Shaw	-	FortisBC	-
Overhead Service		Overhead Service		Overhead Service			

Installed by:	Sanitary service installed by City of Prince George forces	Survey Date:	-
Comments:			

NOT TO SCALE The information contained herein is for internal use only.
Not to be relied on unless confirmed by site inspection and/or investigation.

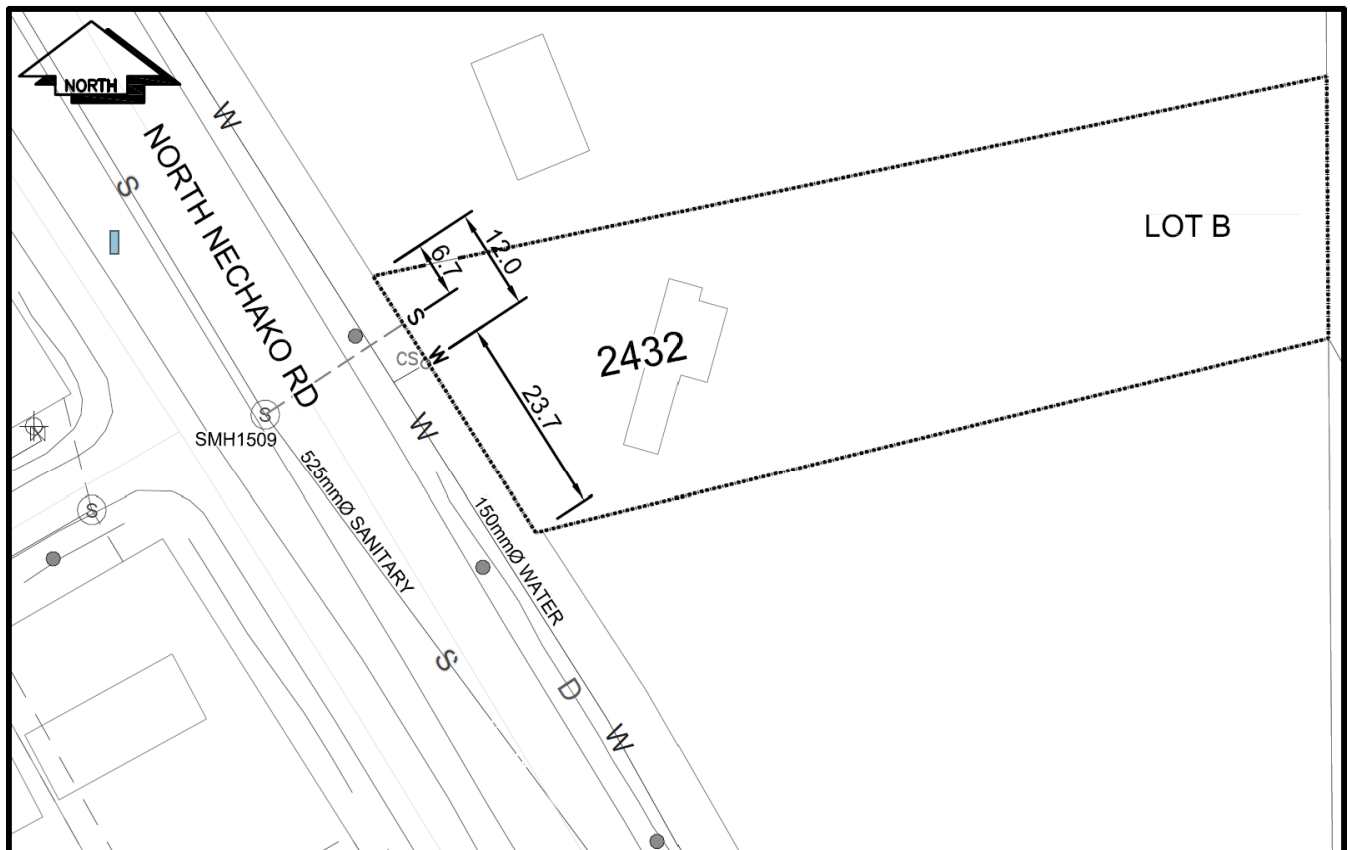

CSO CURB STOP
CO CLEAN OUT
WATER SERVICE
SANITARY SERVICE
STORM SERVICE
GAS

NOT TO SCALE