
## City of Prince George HISTORY SHEET

SHEET NUMBER	11173					Rol	l Number (	013 318993
Legal: LOT'S	A	BLOCK			D.L.	4040	PLAN	8/87
Address:	2178	SHAD.	Y LANE		··· ·· · · · · · · · · · · · · · · · ·			
Sanitary Connection: #	13233	SIZE	4" Ø	MATERIAL		INV. 21	04.35	CONNECTED
Water Connection #		SIZE	3/1/	MATERIAL	Carrie	// METER		CONNECTED
Storm Connection: #		SIZE		MATERIAL	<i>'</i> ,	INV.		CONNECTED
Cash Receipt No's:	WATER		s	ANITARY	1907		STORM	
CURB FROM PROPERTY LINE						PAVEMEN	IT WIDTH	
B.C. HYDRO	UNDERGROUND CONNECTION							
B.C. TELEPHONE	UNDERGROUND CONNECTION							
INLAND GAS								
Information Sheets:	The information contained herein is for							
Comments:	internal use only. Not to be relied upon							
	internal use only. Not to be remainded unless confirmed by site inspection and/or unless investigation.							
		nvestiga	IIIOI I					

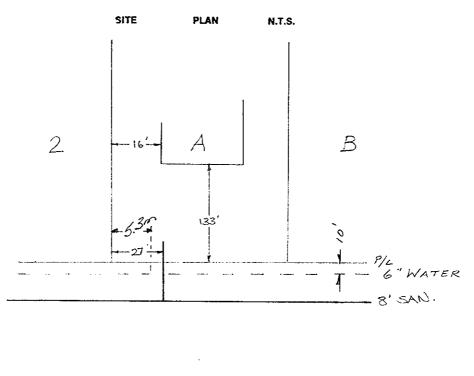

SHADY LANE