


**Lot Servicing**

2423 KNELL RD W  
**Lot: 3, Plan: 1298, DL: 4040**

PID: 013415271

SERVICE	SIZE	MATERIAL	INSTALLED DATE	LOCATION	DETAILS
WATER	20MM	CU		23.8M E OF W PL	CASH RECEIPT NUMBER MU100658
SANITARY	100MM	PVC		C/O 23.2M E OF W PL	CLEANOUT Y

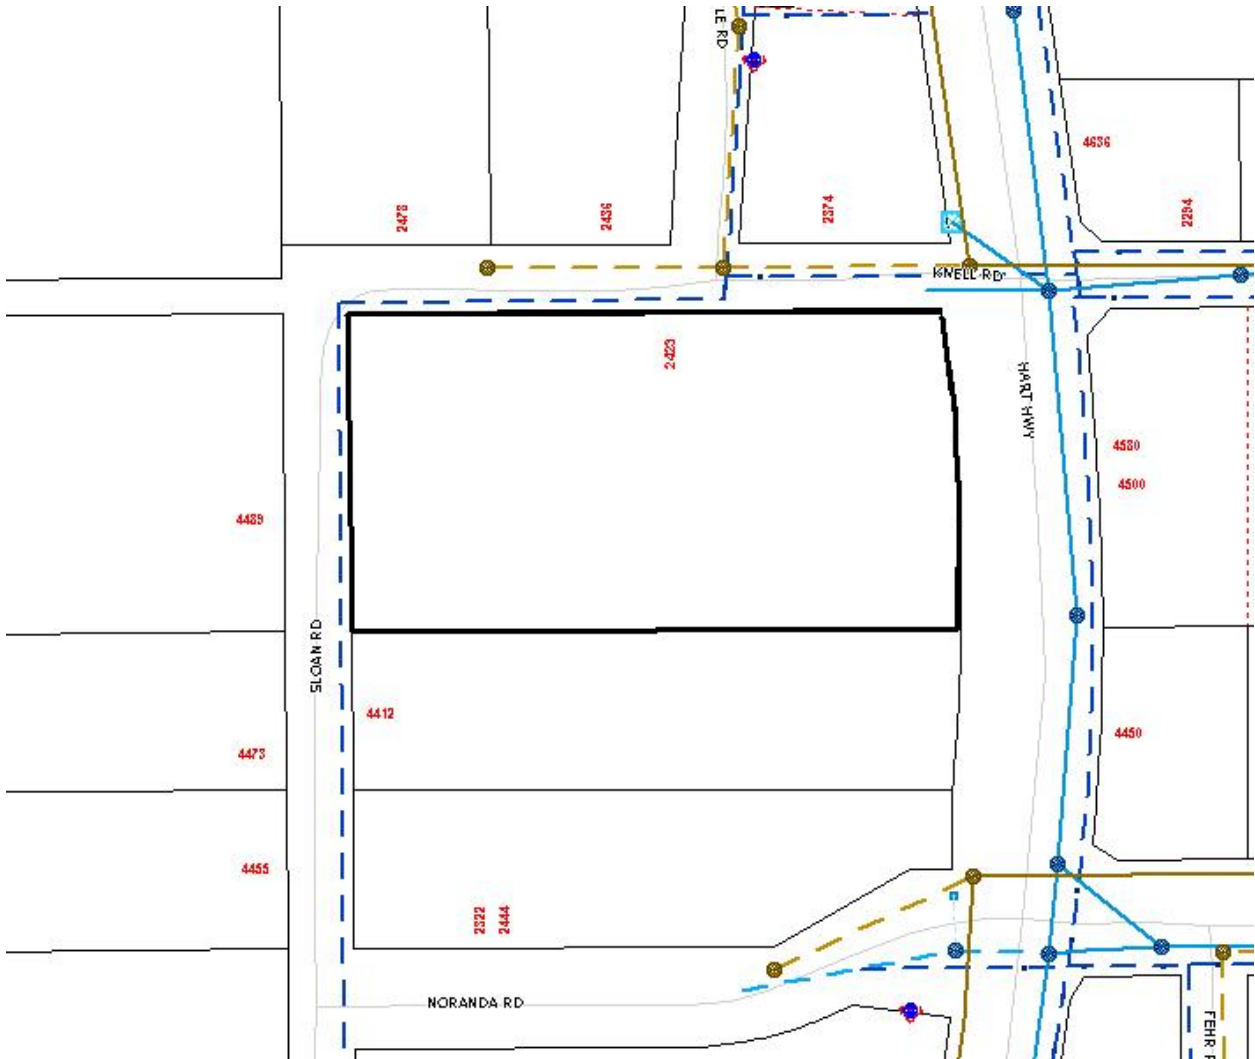

Accuracy not guaranteed unless confirmed by site inspection and/or investigation.  
Connection location between main and property line only.