



# City of Prince George History Sheet

PID:	013437992
SD/MU:	
WO:	

Civic Address: 2126 Tamarack St

Legal Description: Lot: B District Lot: 777 Plan: 8433


Service Type	Diameter (mm)	Material	Invert Elev at main (m)	Invert Elev at property line (m)	Invert Depth at service end (m)	Distance into property (m)	Installation Date
Sanitary	100mm	AC	-	-	2.01	-	December 1964
Water	20mm	Copper	-	-	-	-	December 1964
Storm	N/A	N/A	-	-	-	-	

Service Connection Location				Sanitary (m)	Storm (m)
Distance from downstream San MH	3383	towards upstream San MH	3381	1.00	
Distance from downstream Stm MH	-	towards upstream Stm MH	-		

Power	Size	Communications	Size	Cable	Size	Gas	Size
BC Hydro	-	Telus	-	Shaw	-	FortisBC	-
Overhead Service		Overhead Service		Overhead Service			

Installed by:	Survey Date:	-
Comments:	Water and sewer services confirmed September 2019	

**NOT TO SCALE** The information contained herein is for internal use only.  
Not to be relied on unless confirmed by site inspection and/or investigation.

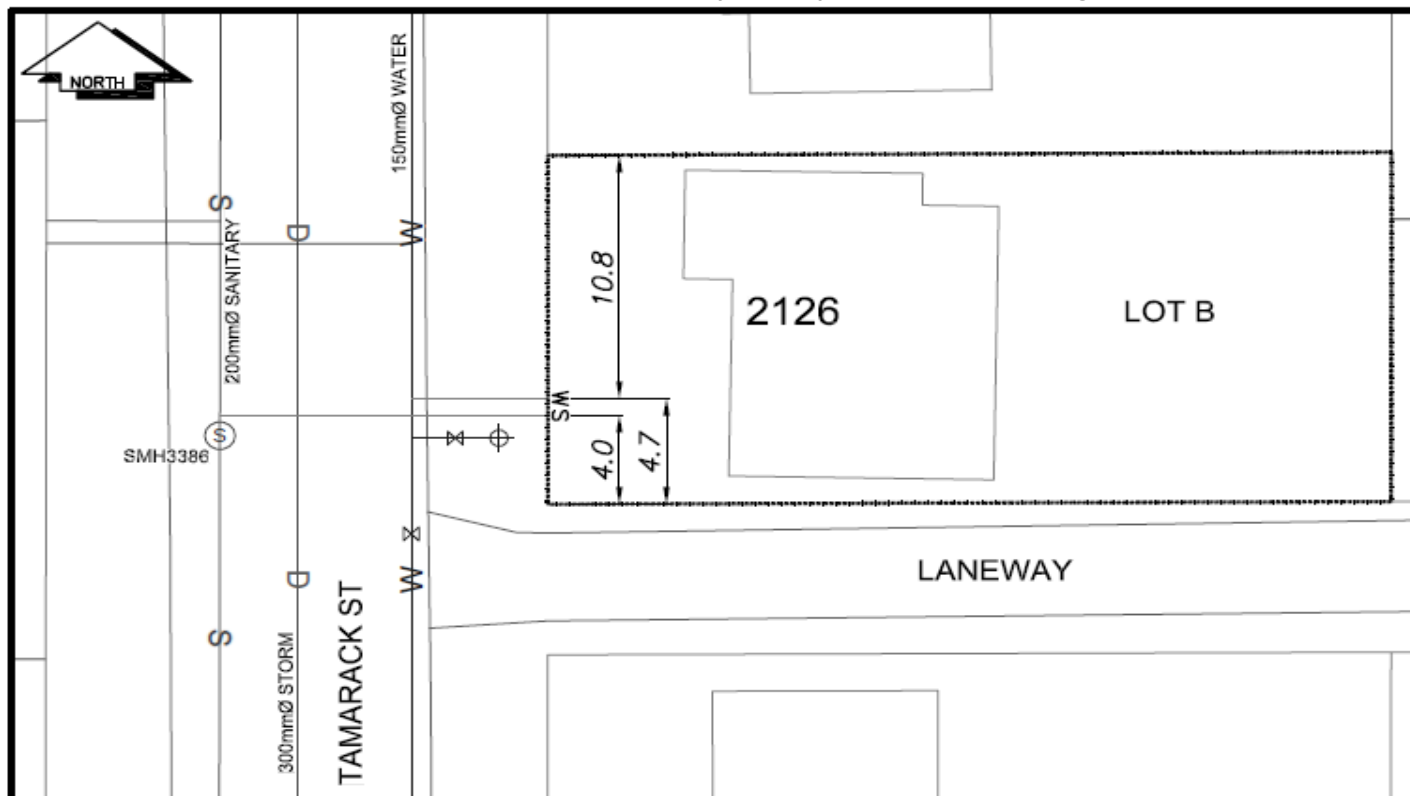

CS <sup>o</sup> CURB STOP	— W — WATER SERVICE	— S — STORM SERVICE
CO <sup>o</sup> CLEAN OUT	- - - S - SANITARY SERVICE	— G — GAS
⊗ WATER VALVE	⊗ FIRE HYDRANT	- - - - - ENCUMBRANCE

**NOT TO SCALE**