



City of Prince George History Sheet

PID:	013476891
SD/MU:	
WO:	

Civic Address: 1363 Blackburn Rd

Legal Description: Lot: 8 District Lot: 632 Plan: 1243 except Plan EPP68929


Service Type	Diameter (mm)	Material	Invert Elev at main (m)	Invert Elev at property line (m)	Invert Elev at service end (m)	Distance into property (m)	Installation Date
Sanitary	N/A	N/A	-	-	-	-	-
Water	N/A	N/A	-	-	-	-	
Storm	N/A	N/A	-	-	-	-	

Service Connection Location						Sanitary (m)	Storm (m)
Distance from downstream San MH			-	towards upstream San MH	-	-	
Distance from downstream Stm MH			-	towards upstream Stm MH	-		

Power	Size	Communications	Size	Cable	Size	Gas	Size
BC Hydro	-	Telus	-	Shaw	-	FortisBC	-
Overhead Service		Overhead Service		Overhead Service			

Installed by:	Survey Date:	-
Comments:		

NOT TO SCALE The information contained herein is for internal use only.
Not to be relied on unless confirmed by site inspection and/or investigation.

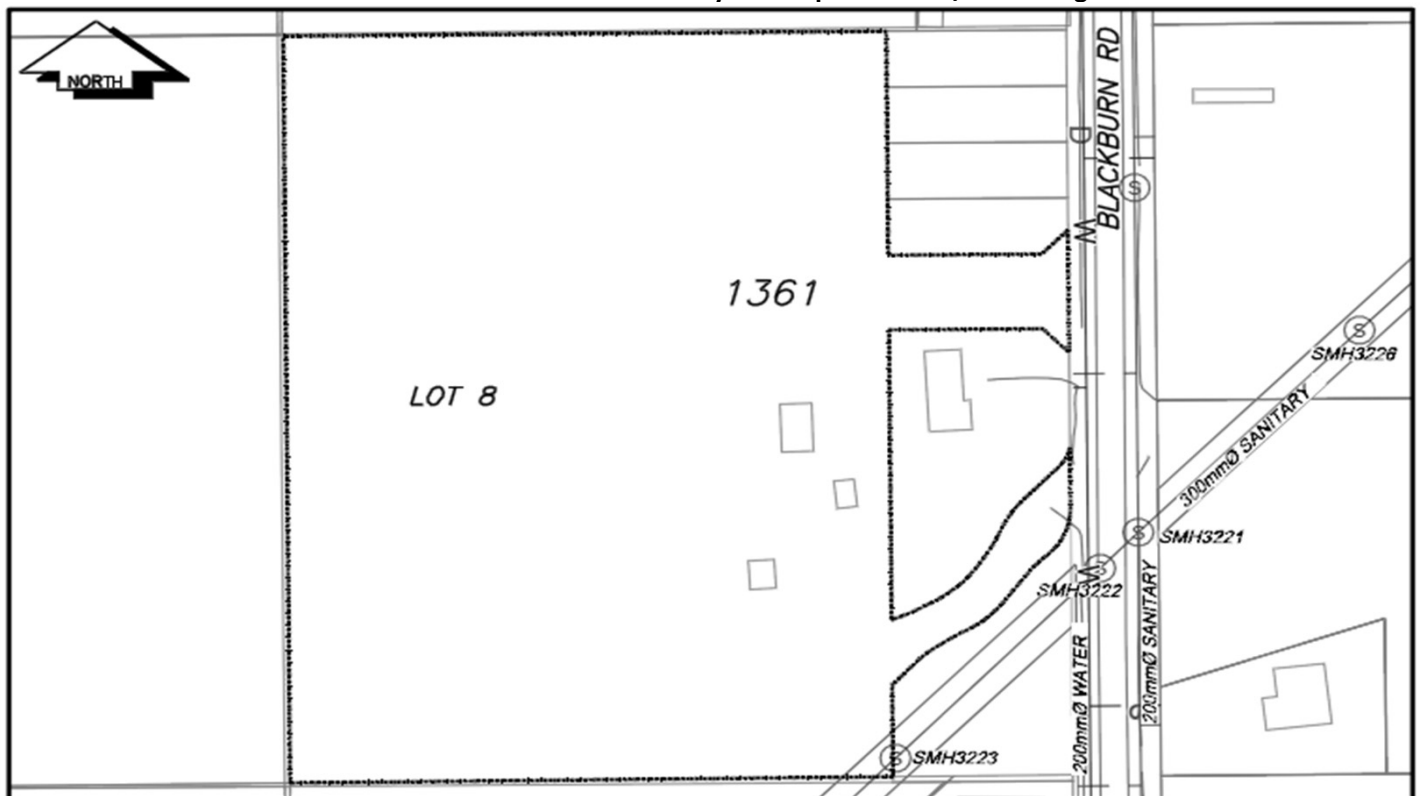

CS ^o CURB STOP	--- W WATER SERVICE	--- S SANITARY SERVICE	--- Ø STORM SERVICE
CO ^o CLEAN OUT	--- S SANITARY SERVICE	--- G GAS	--- ENCUMBRANCE
⊗ WATER VALVE	⊗ FIRE HYDRANT		

NOT TO SCALE