



# City of Prince George History Sheet

PID:	013519301
MU:	101441
WO:	73164

Civic Address: 3803 Hart Hwy

Legal Description: Lot: 1 District Lot: 4040 Plan: 6524


Service Type	Diameter (mm)	Material	Invert Elev at main (m)	Invert Elev at property line (m)	Invert Elev at service end (m)	Distance into property (m)	Installation Date
Sanitary	100mm	PVC	-	-	-	-	December 1976
Water	50mm	Copper	-	-	-	-	December 1971
Storm	N/A	N/A	-	-	-	-	

Service Connection Location			Sanitary (m)	Storm (m)
Distance from downstream San MH	1393	towards upstream termination of main	43.60	
Distance from downstream Stm MH	-	towards upstream Stm MH	-	

Power	Size	Communications	Size	Cable	Size	Gas	Size
BC Hydro	-	Telus	-	Shaw	-	FortisBC	-
Overhead Service		Overhead Service		Overhead Service			

Installed by:	City of Prince George forces	Survey Date:	-
Comments:	Secondary water connection disconnected Sept 18, 2013 (20mm off Hart Hwy to former burger bar)		

**NOT TO SCALE** The information contained herein is for internal use only.  
Not to be relied on unless confirmed by site inspection and/or investigation.

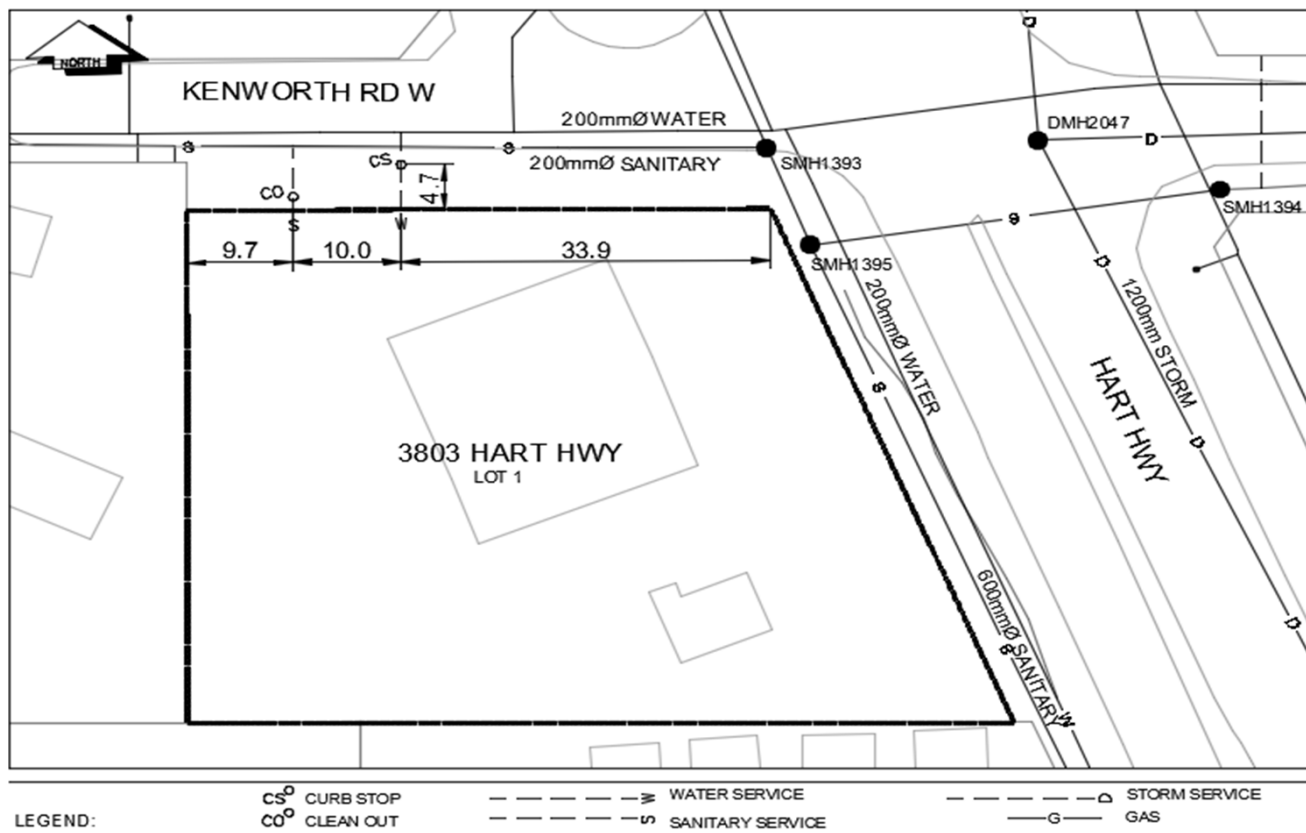

**NOT TO SCALE**