



City of Prince George History Sheet

| | |
|--------|-----------|
| PID: | 013565974 |
| SD/MU: | |
| WO: | |

Civic Address: 2165 Robertson Rd

Legal Description: Lot: 4 Block: 2 District Lot: 2508 Plan: 6087Rem


| Service Type | Diameter (mm) | Material | Invert Elev at main (m) | Invert Elev at property line (m) | Invert Elev at service end (m) | Distance into property (m) | Installation Date |
|--------------|---------------|----------|-------------------------|----------------------------------|--------------------------------|----------------------------|-------------------|
| Sanitary | 100mm | AC | - | - | - | - | December 1971 |
| Water | 20mm | Copper | - | - | - | - | December 1978 |
| Storm | 100mm | AC | - | - | - | - | December 1973 |

| Service Connection Location | | | | Sanitary (m) | Storm (m) |
|---------------------------------|------|-------------------------|------|--------------|-----------|
| Distance from downstream San MH | 3237 | towards upstream San MH | 3238 | 71.56 | |
| Distance from downstream Stm MH | 3119 | towards upstream Stm MH | 3118 | | 132.11 |

| Power | Size | Communications | Size | Cable | Size | Gas | Size |
|------------------|------|------------------|------|------------------|------|----------|------|
| BC Hydro | - | Telus | - | Shaw | - | FortisBC | - |
| Overhead Service | | Overhead Service | | Overhead Service | | | |

| | | |
|---------------|--------------|---|
| Installed by: | Survey Date: | - |
| Comments: | | |
| | | |
| | | |

NOT TO SCALE The information contained herein is for internal use only.
Not to be relied on unless confirmed by site inspection and/or investigation.

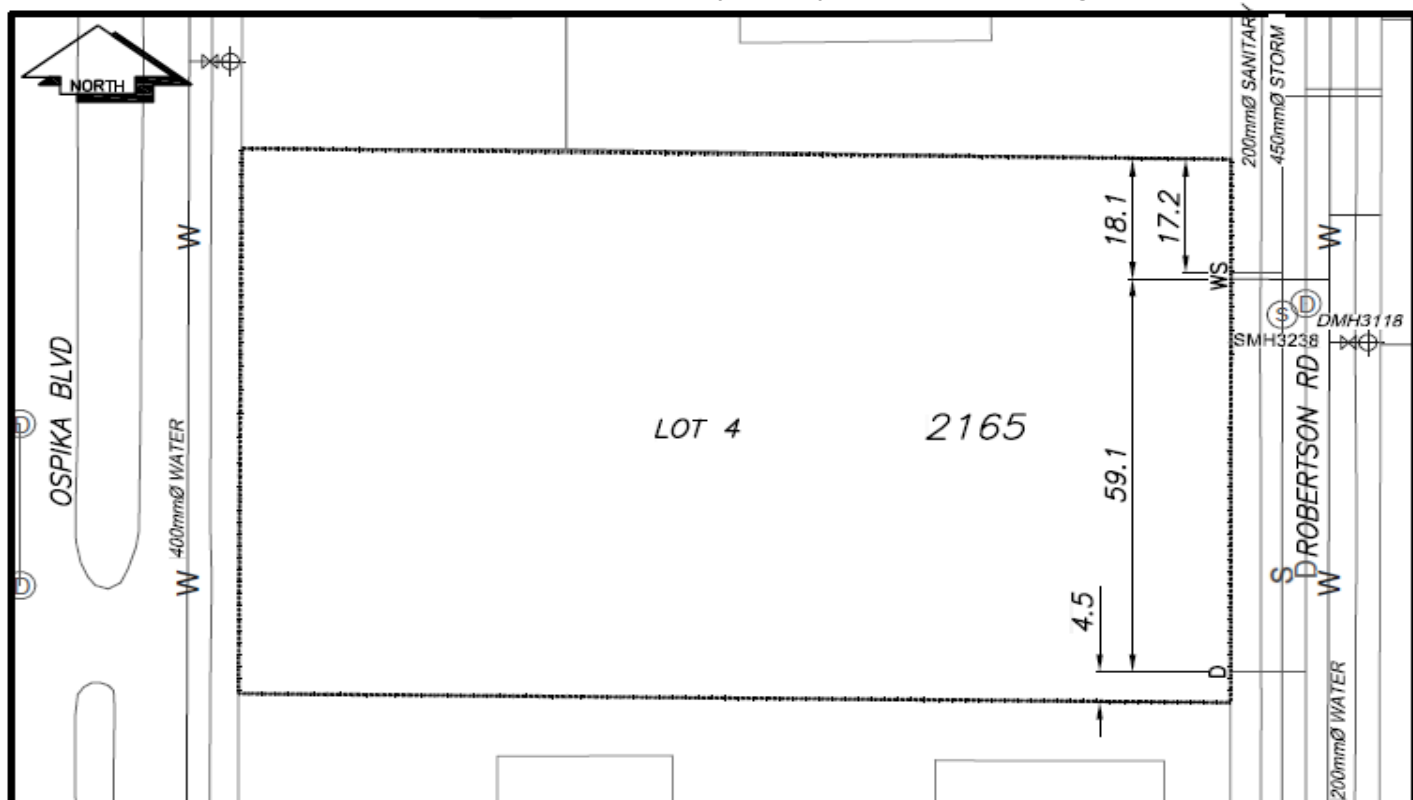

| | | | |
|---------------------------|------------------------|------------------------|-----------|
| CS ^o CURB STOP | — W — WATER SERVICE | — S — SANITARY SERVICE | — G — GAS |
| CO ^o CLEAN OUT | — — — — — FIRE HYDRANT | — — — — — ENCUMBRANCE | |
| WATER VALVE | | | |

NOT TO SCALE