



# City of Prince George History Sheet

PID:	013623362
SD/MU:	
WO:	5001450

Civic Address: 1744, 1776 Strathcona Ave

Legal Description: Lot: 12 Block: H District Lot: 777 Plan: 5566


Service Type	Diameter (mm)	Material	Invert Elev at main (m)	Invert Elev at property line (m)	Invert Elev at service end (m)	Distance into property (m)	Installation Date
Sanitary	Unknown	Unknown	-	-	-	-	-
Water	25mm	Copper	567.12	567.30	-	-	August 2019
Storm	N/A	N/A	-	-	-	-	

Service Connection Location						Sanitary (m)	Storm (m)
Distance from downstream San MH	-	towards upstream San MH	-	-	-	-	
Distance from downstream Stm MH	-	towards upstream Stm MH	-	-	-		

Power	Size	Communications	Size	Cable	Size	Gas	Size
BC Hydro	-	Telus	-	Shaw	-	FortisBC	-
Overhead Service		Overhead Service		Overhead Service			

Installed by:	Water service installed bt City of Prince George forces	Survey Date:	-
Comments:			

**NOT TO SCALE** The information contained herein is for internal use only.  
Not to be relied on unless confirmed by site inspection and/or investigation.

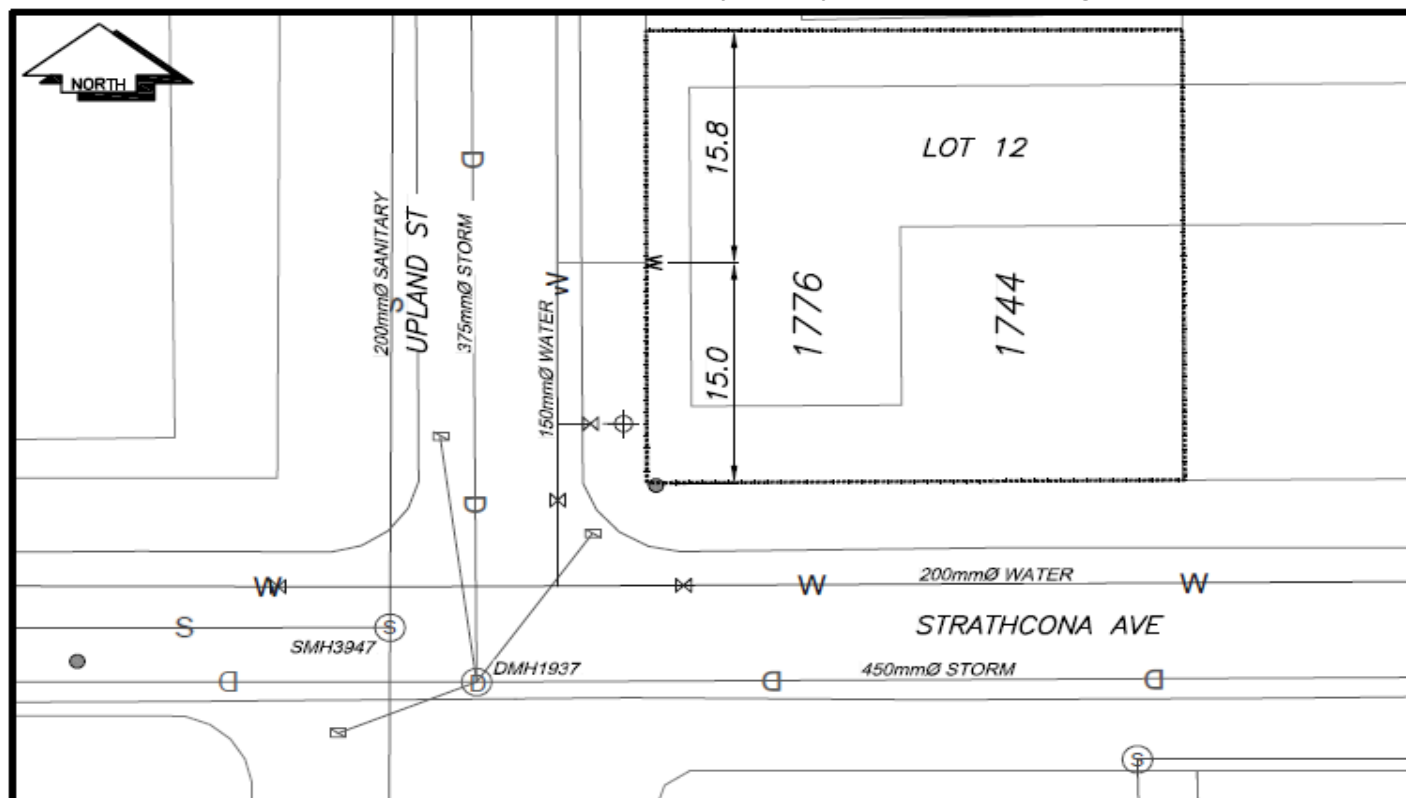

**NOT TO SCALE**