


Lot Servicing

2144 REDWOOD ST

PID: 013648616

Lot: 19, Block: K, Plan: 5566, DL: 777

SERVICE	SIZE	MATERIAL	INSTALLED DATE	LOCATION	DETAILS
WATER	20MM	CU		FR NW COR BLD 9.0M W	
SANITARY	UNKNOWN	UNKNOWN		NO LOCATION NO C/O	connected

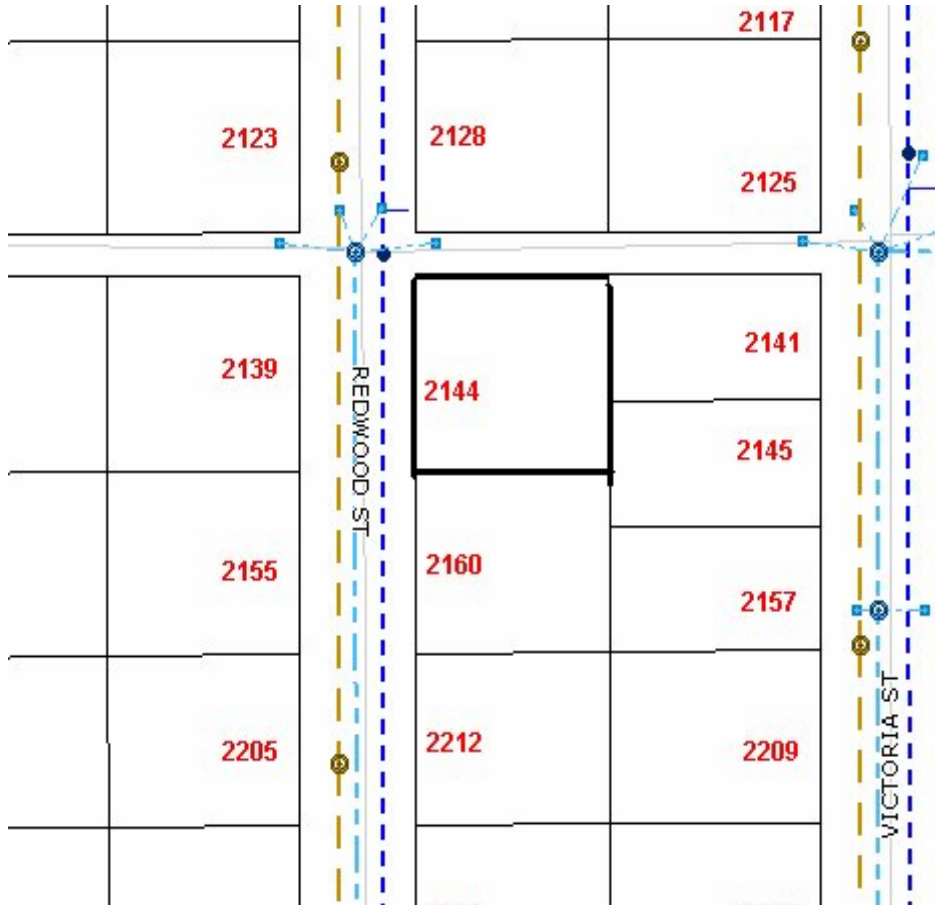

Accuracy not guaranteed unless confirmed by site inspection and/or investigation.
Connection location between main and property line only.