

City of Prince George

HISTORY SHEET

HK

SHEET NUMBER _____ Roll Number 013680 360

Legal: LOT'S 6 BLOCK I D.L. 777 PLAN 5566

Address: 2135 - 2137 SPRUCE ST.

Sanitary Connection: # 4796 SIZE 100 mm MATERIAL A.C.S INV. _____ CONNECTED _____

Water Connection # 4212 SIZE 20 mm MATERIAL COPPER METER _____ CONNECTED _____

Storm Connection: # _____ SIZE _____ MATERIAL _____ INV. _____ CONNECTED _____

Cash Receipt No's: WATER _____ SANITARY _____ STORM _____

CURB FROM PROPERTY LINE 4.877 m PAVEMENT WIDTH 10.363 m

B.C. HYDRO O/H UNDERGROUND CONNECTION _____



B.C. TELEPHONE O/H UNDERGROUND CONNECTION _____

INLAND GAS AS SHOWN

Information Sheets: _____

Comments: _____

**THE INFORMATION CONTAINED HEREIN IS FOR INTERNAL USE ONLY.
NOT TO BE RELIED UPON UNLESS CONFIRMED BY SITE INSPECTION AND/OR INVESTIGATION**

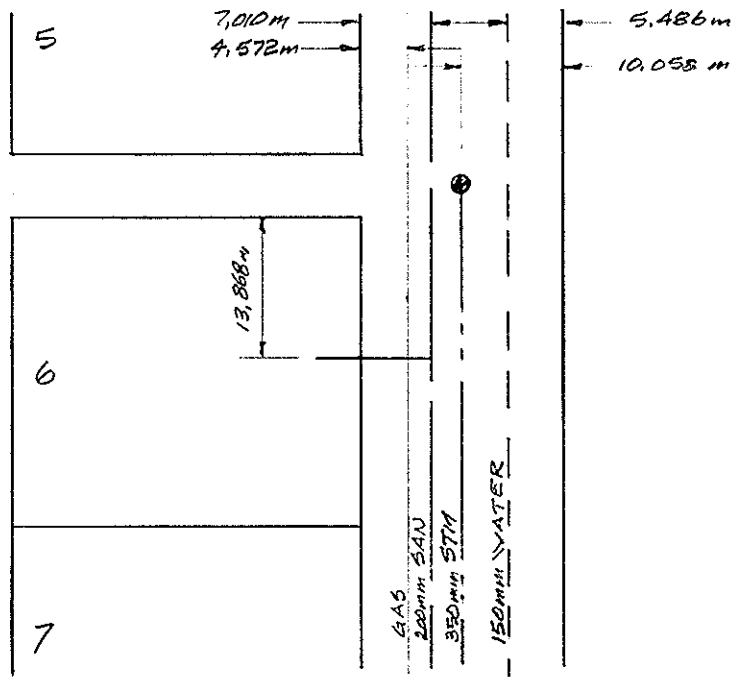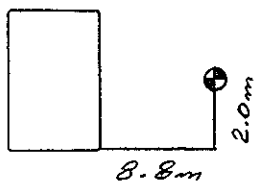

SPRUCE ST.