


## Lot Servicing

2111 SPRUCE ST 2117 SPRUCE ST  
**Lot: 5, Block: I, Plan: 5566, DL: 777 REM**

PID: 013650394

SERVICE	SIZE	MATERIAL	INSTALLED DATE	LOCATION	DETAILS
WATER	20MM	UNKNOWN	31-Oct-1979	FR NE COR PL 1.524M E 8.229M S; (2117 SPRUCE) S/P 10.9M S OF N PL	CASH RECEIPT NUMBER 2378
WATER	25MM	CU	16-Sep-2009	(2111 SPRUCE) SP 8.5M S OF N PL	CASH RECEIPT NUMBER 101004
SANITARY	100MM	PVC		(2111 SPRUCE) C/O 8.8M S OF N PL	CLEANOUT 8.8M S OF N PL
SANITARY	100MM	PVC	10-Oct-1979	(2117 SPRUCE) C/O 10.5M S OF N PL	CLEANOUT 10.5M S OF N PL

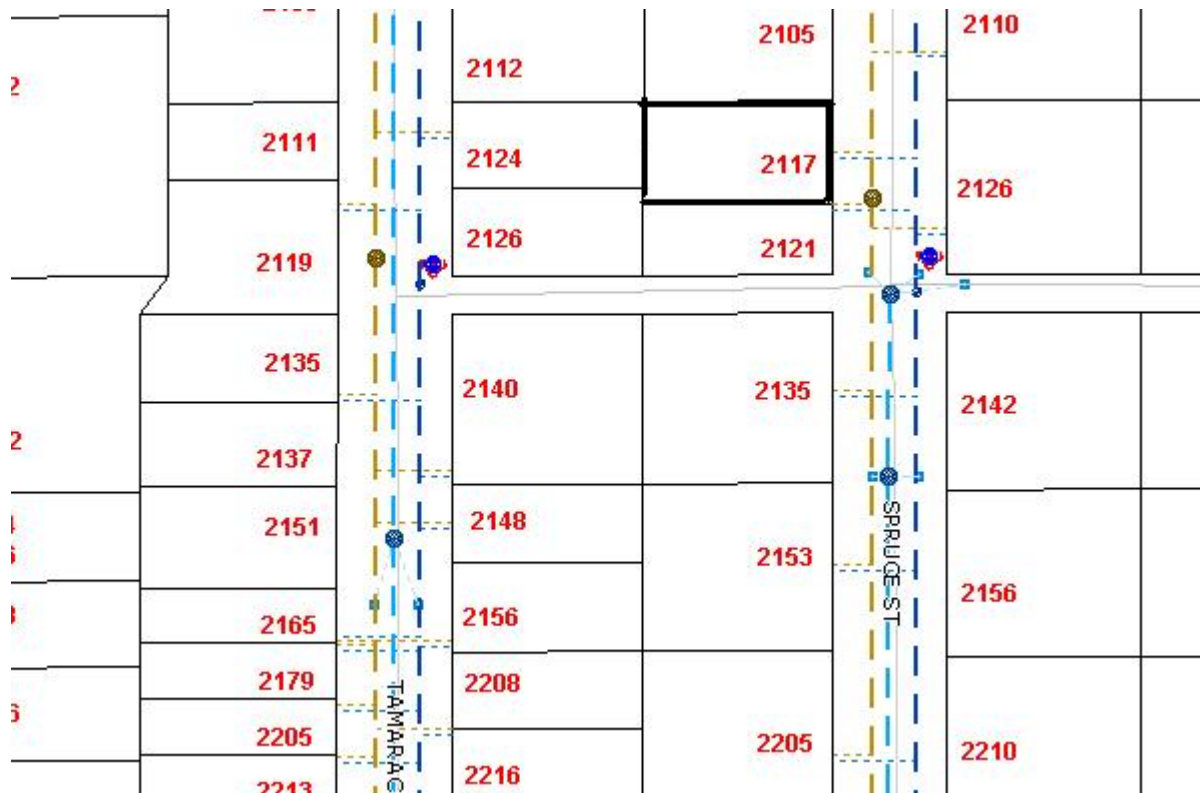

Accuracy not guaranteed unless confirmed by site inspection and/or investigation.  
 Connection location between main and property line only.