


Lot Servicing

6300 BIRCHWOOD DR
Lot: 22, Plan: 17033, DL: 4047

PID: 013742906

SERVICE	SIZE	MATERIAL	INSTALLED DATE	LOCATION	DETAILS
WATER	20MM	CU	23-Nov-2007	10.2M S OF NW COR PL	CASH RECEIPT NUMBER 100783
SANITARY	100MM	UNKNOWN	29-Oct-2007	13.6M W OF NE COR PL	CONNECTION # 36534

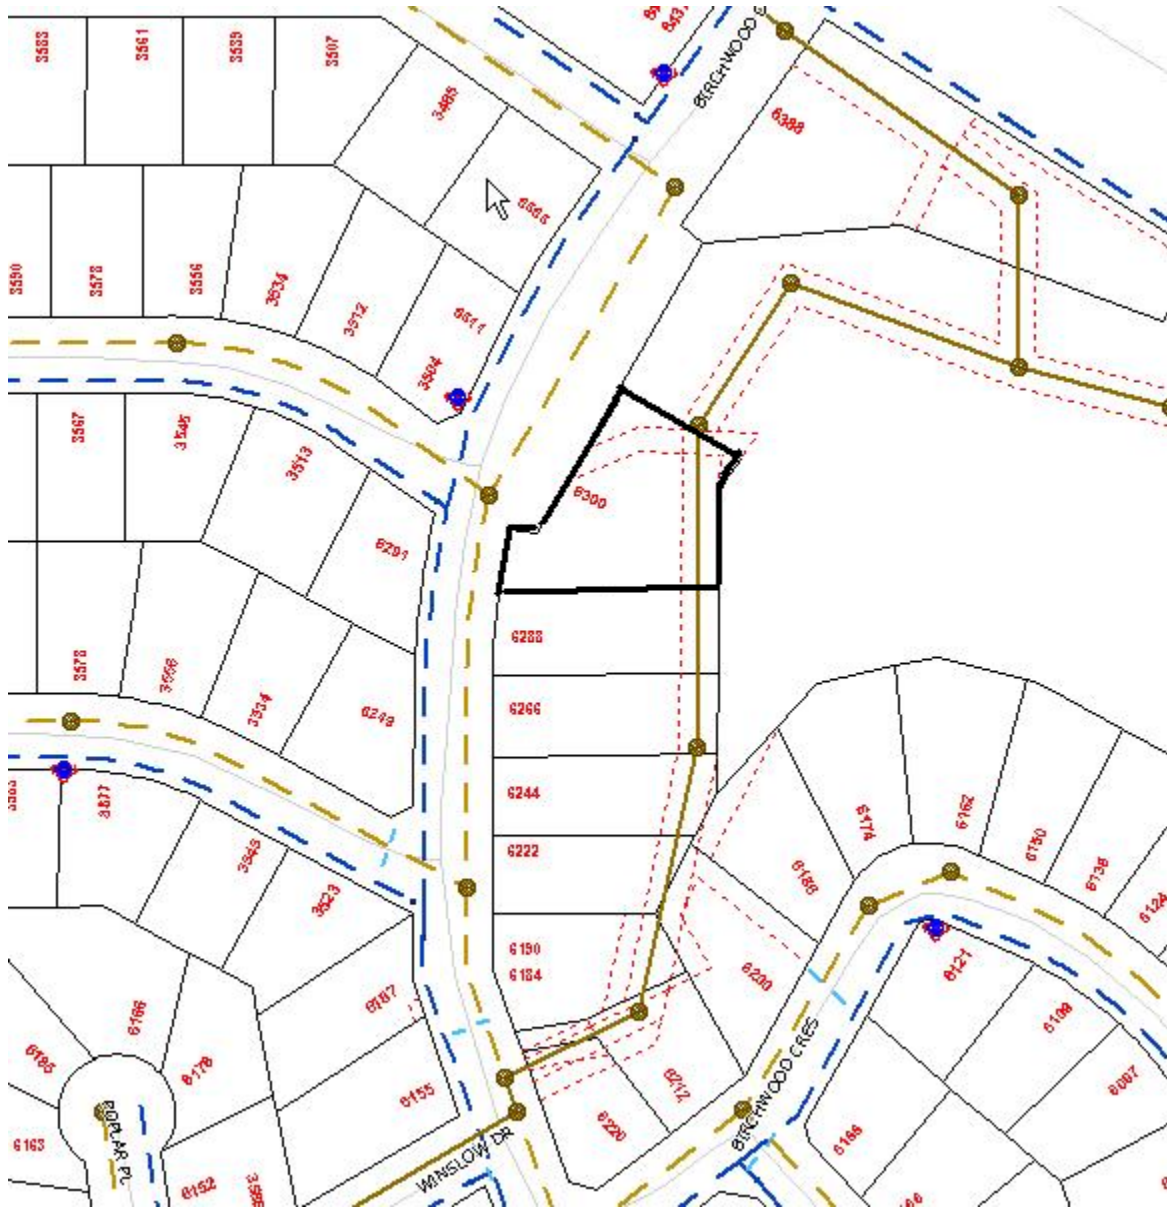

Accuracy not guaranteed unless confirmed by site inspection and/or investigation.
Connection location between main and property line only.