


Lot Servicing

623 PRESTON RD

PID: 013889290

Lot: 2, Plan: 1454, DL: 3050

SERVICE	SIZE	MATERIAL	INSTALLED DATE	LOCATION	DETAILS
WATER	19MM	CU	17-Jun-1994	52.725M WEST OF EAST PL	THAW WIRE YES
SANITARY	100MM	PVC	17-Jun-1994	51.725M WEST OF EAST PL	INV OF MAIN TO CONN POINT 570.039

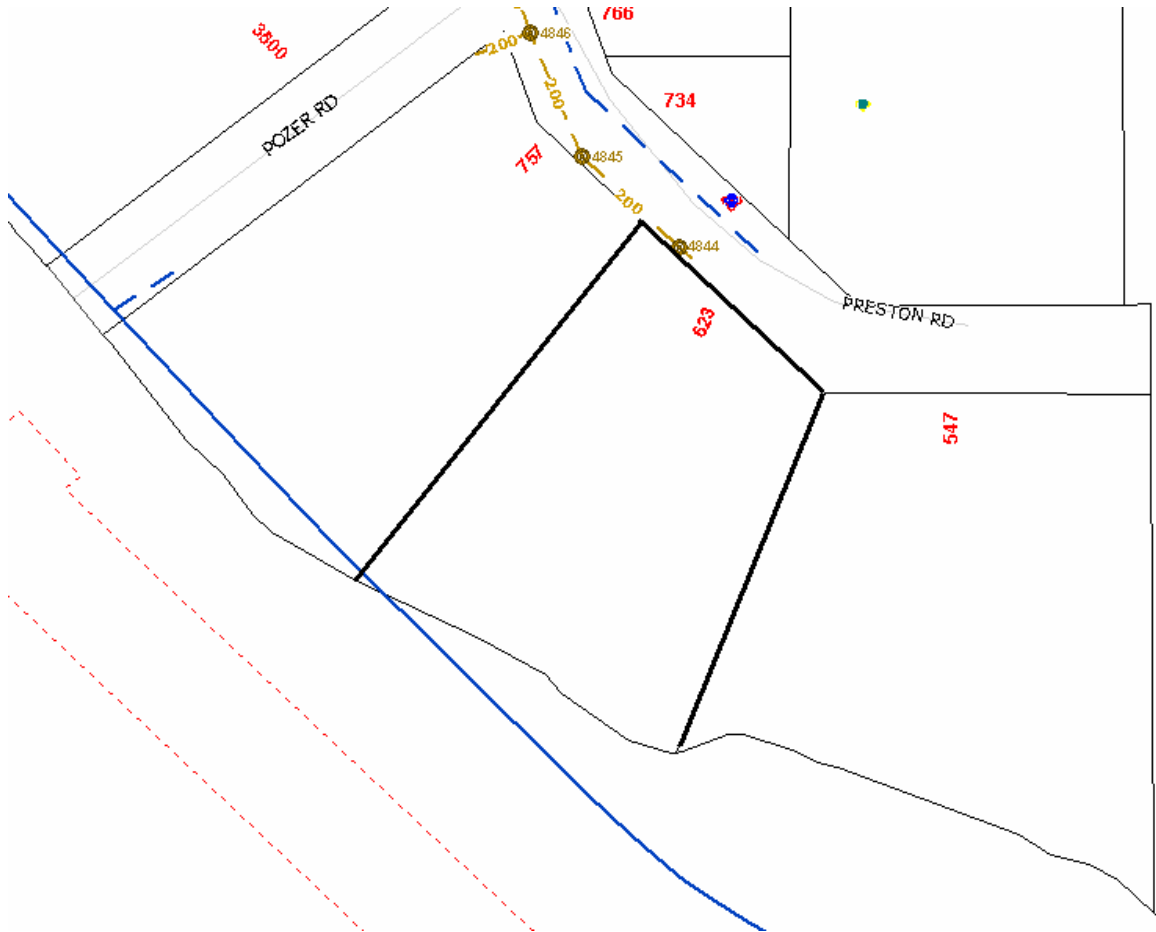

Accuracy not guaranteed unless confirmed by site inspection and/or investigation.
Connection location between main and property line only.