



City of Prince George
History Sheet

PID:	013923056
MU:	101666
WO:	85335

Civic Address: 2319 McMillan Drive

Legal Description: Lot: 38 District Lot: 4377 Plan: 1329


Service Type	Diameter (mm)	Material	Invert Elev at main (m)	Invert Elev at property line (m)	Invert Elev at service end (m)	Distance into property (m)	Installation Date
Sanitary	100mm	PVC	-	-	-	-	October 2015
Water	20mm	Copper	-	-	-	-	January 1972
Storm	N/A	N/A	-	-	-	-	

Service Connection Location	Sanitary (m)	Storm (m)
100mm Sanitary service connection connected to San MH 1540	-	
Distance from downstream Stm MH - towards upstream Stm MH -		

Power	Size	Communications	Size	Cable	Size	Gas	Size
BC Hydro	-	Telus	-	Shaw	-	FortisBC	-
Overhead Service		Overhead Service		Overhead Service			

Installed by: City of Prince George forces	Survey Date: -
Comments:	

NOT TO SCALE The information contained herein is for internal use only.
Not to be relied on unless confirmed by site inspection and/or investigation.

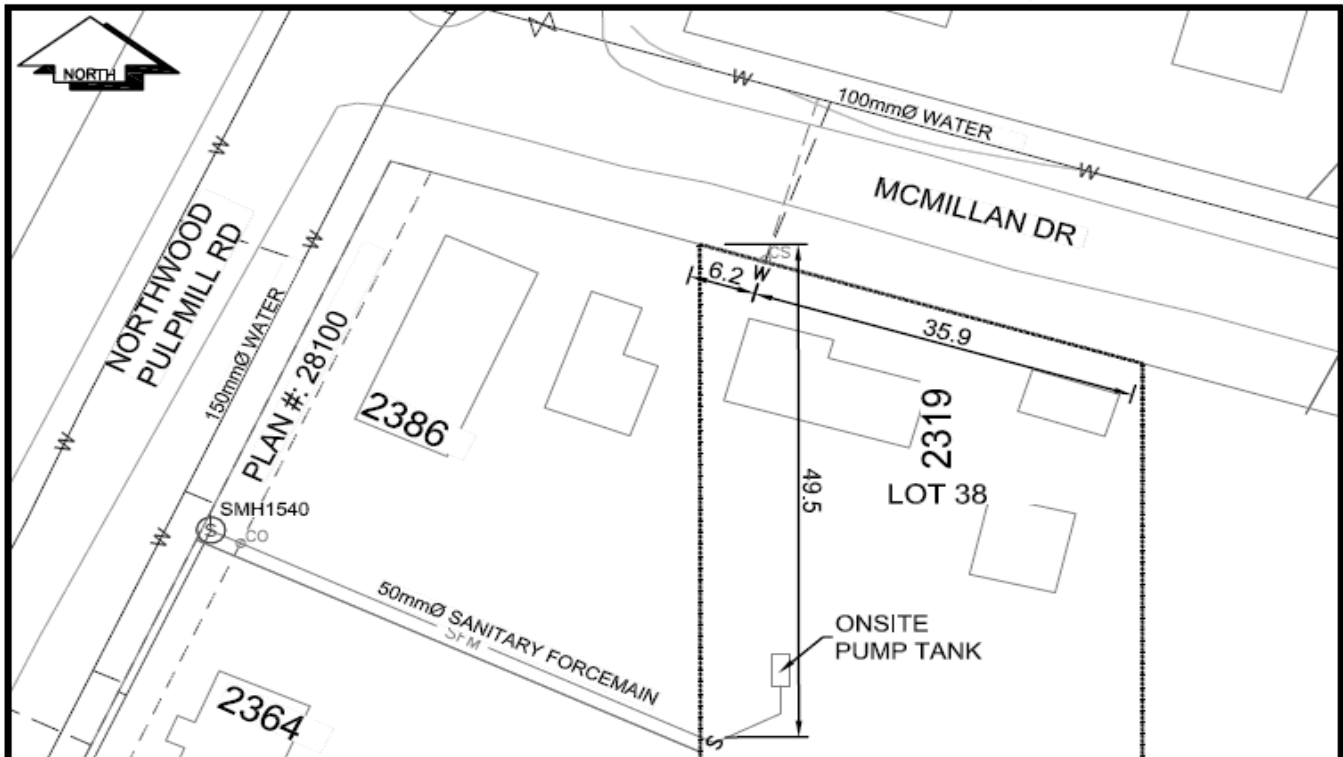

LEGEND:	CS CURB STOP	--- WATER SERVICE	--- STORM SERVICE
	CO CLEAN OUT	--- SANITARY SERVICE	--- GAS

NOT TO SCALE