



# City of Prince George History Sheet

PID:	013939718
	013939751
SD/MU:	
WO:	

Civic Address: 2274 Queensway

Legal Description: Lot: 1 2 Block: 26 District Lot: 417 Plan: 1409


Service Type	Diameter (mm)	Material	Invert Elev at main (m)	Invert Elev at property line (m)	Invert Depth at service end (m)	Distance into property (m)	Installation Date
Sanitary	100mm	AC	-	-	-	-	December 1980
Water (W1)	20mm	Copper	-	-	-	-	December 1954
Water (W2)	20mm	Copper	-	-	-	-	June 2015
Storm	150mm	AC	-	-	2.13	-	December 1977

Service Connection Location				Sanitary (m)	Storm (m)
Distance from downstream San MH	1722	towards upstream San MH	1727	70.34	
Distance from downstream Stm MH	-	towards upstream Stm MH	-		

Power	Size	Communications	Size	Cable	Size	Gas	Size
BC Hydro	-	Telus	-	Shaw	-	FortisBC	-
Overhead Service		Overhead Service		Overhead Service			

Installed by:	W2 Water service installed by City of Prince George forces	Survey Date:	-
Comments:			

**NOT TO SCALE** The information contained herein is for internal use only.  
Not to be relied on unless confirmed by site inspection and/or investigation.

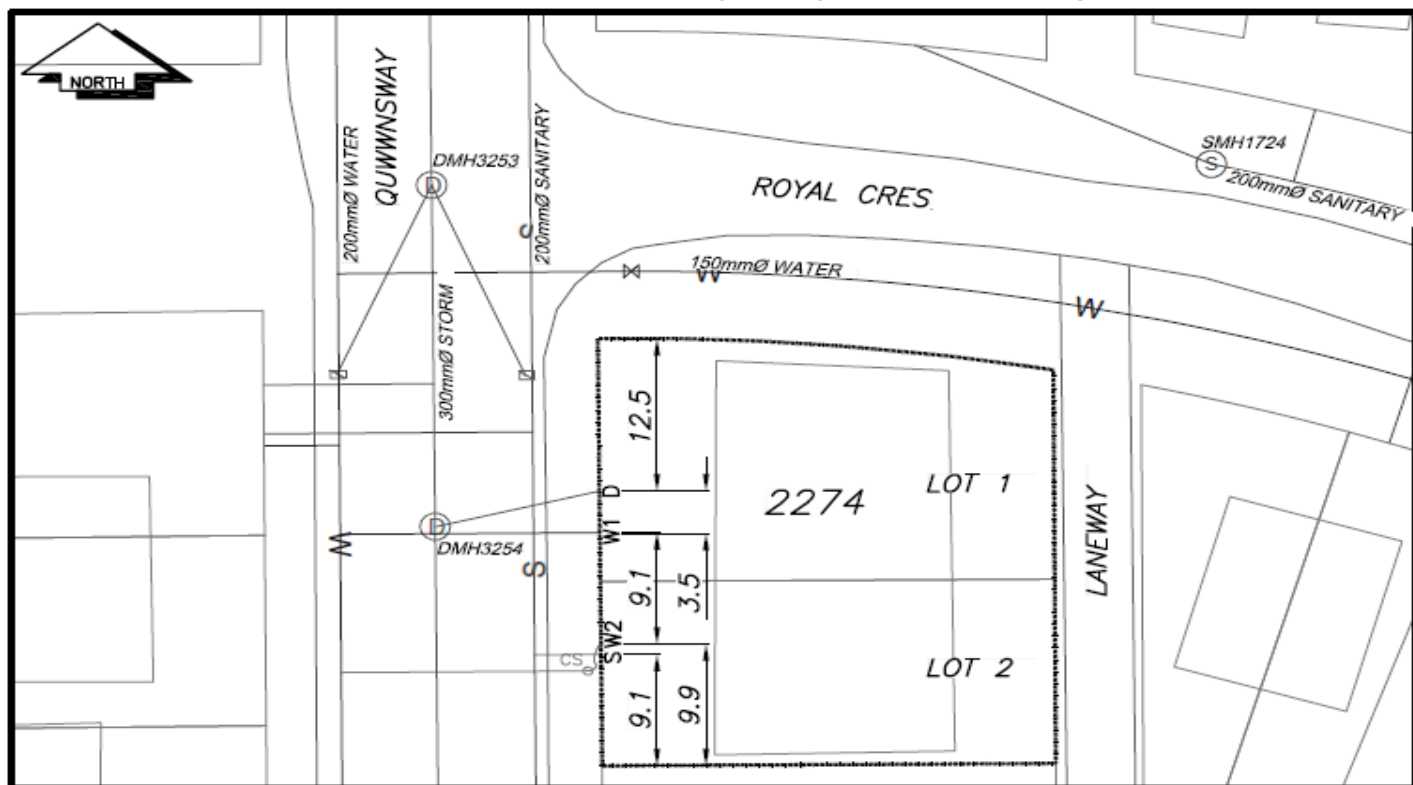

CS	CURB STOP	W	WATER SERVICE	D	STORM SERVICE
CO	CLEAN OUT	S	SANITARY SERVICE	G	GAS
X	WATER VALVE	⊗	FIRE HYDRANT	- - - -	ENCUMBRANCE

**NOT TO SCALE**