


Lot Servicing

928 HART HWY
Lot: 17, Plan: 1338, DL: 2440

PID: 013964402

SERVICE	SIZE	MATERIAL	INSTALLED DATE	LOCATION	DETAILS
WATER	50MM	CU	25-Sep-2007	4.3M S OF N PL-thru easement on Lot 10	CASH RECEIPT NUMBER 100769

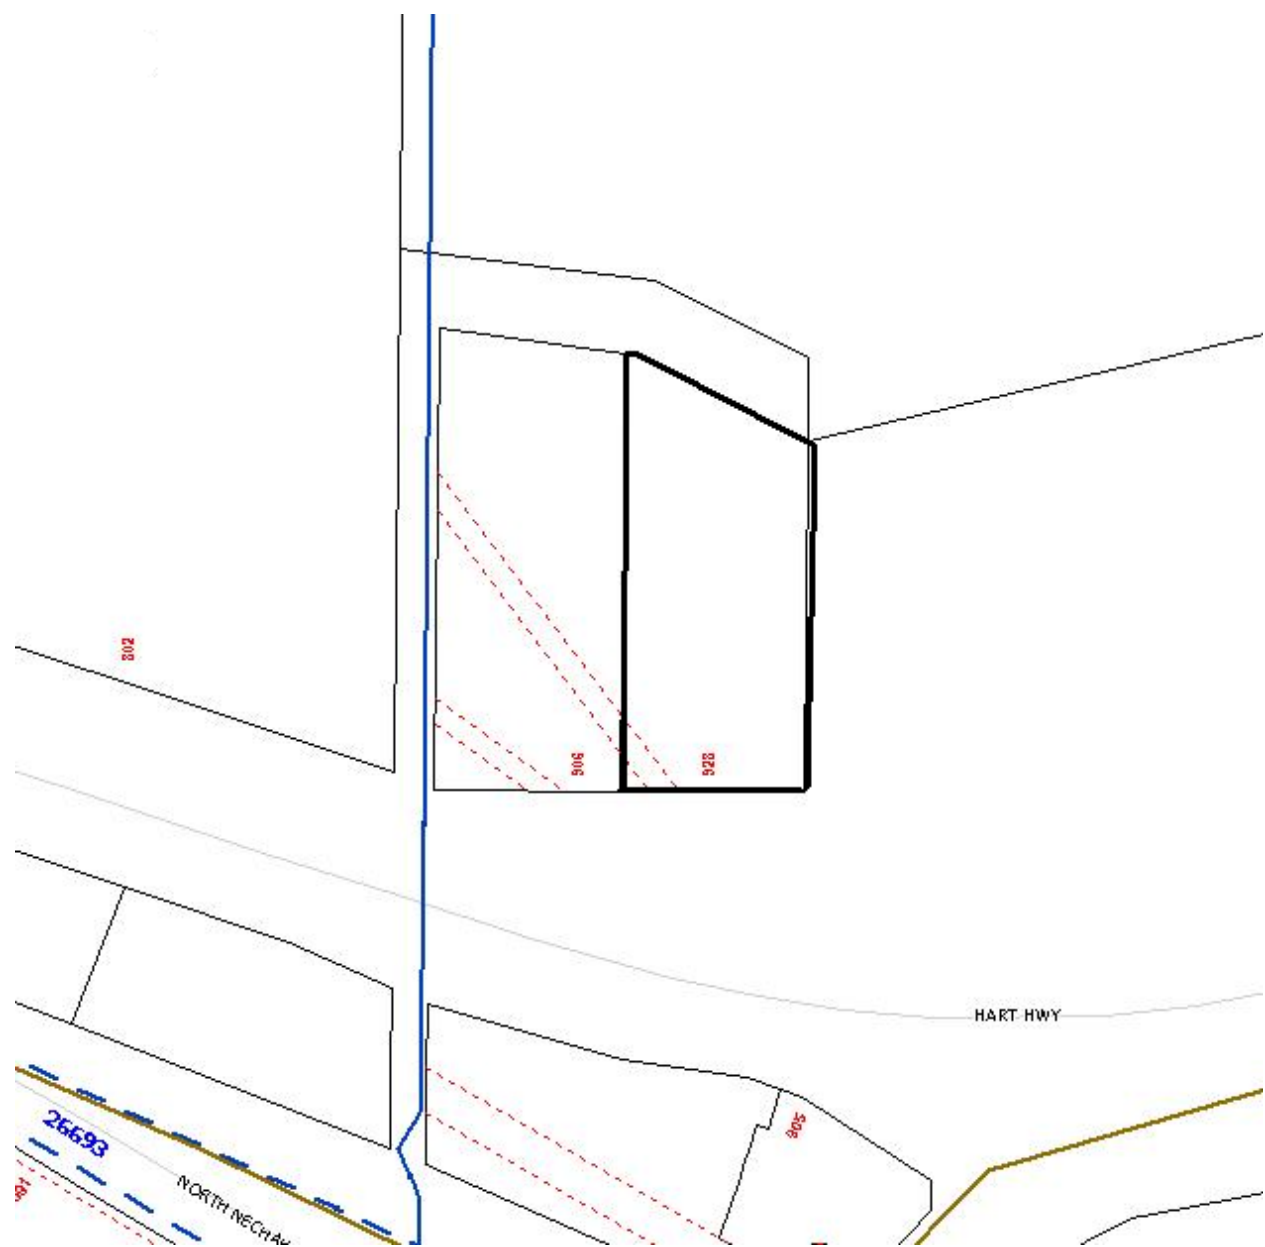

Accuracy not guaranteed unless confirmed by site inspection and/or investigation.
Connection location between main and property line only.