



City of Prince George History Sheet

PID:	013966243
SD/MU:	
WO:	

Civic Address: 4349, 4387 Shamrock Rd

Legal Description: Lot: 16 District Lot: 4040 Plan: 1298


Service Type	Diameter (mm)	Material	Invert Elev at main (m)	Invert Elev at property line (m)	Invert Elev at service end (m)	Distance into property (m)	Installation Date
Sanitary	100mm	PVC	-	-	-	-	December 1977
Water (W1)	20mm	Copper	-	-	-	-	December 1971
Water (W2)	20mm	Copper	-	-	-	-	December 1971
Storm	N/A	N/A	-	-	-	-	

Service Connection Location				Sanitary (m)	Storm (m)
Distance from downstream San MH	1357	towards upstream San MH	1353	14.68	
Distance from downstream Stm MH	-	towards upstream Stm MH	-		

Power	Size	Communications	Size	Cable	Size	Gas	Size
BC Hydro	-	Telus	-	Shaw	-	FortisBC	-
Overhead Service		Overhead Service		Overhead Service			

Installed by:	Survey Date:	-
Comments:		

NOT TO SCALE The information contained herein is for internal use only.
Not to be relied on unless confirmed by site inspection and/or investigation.

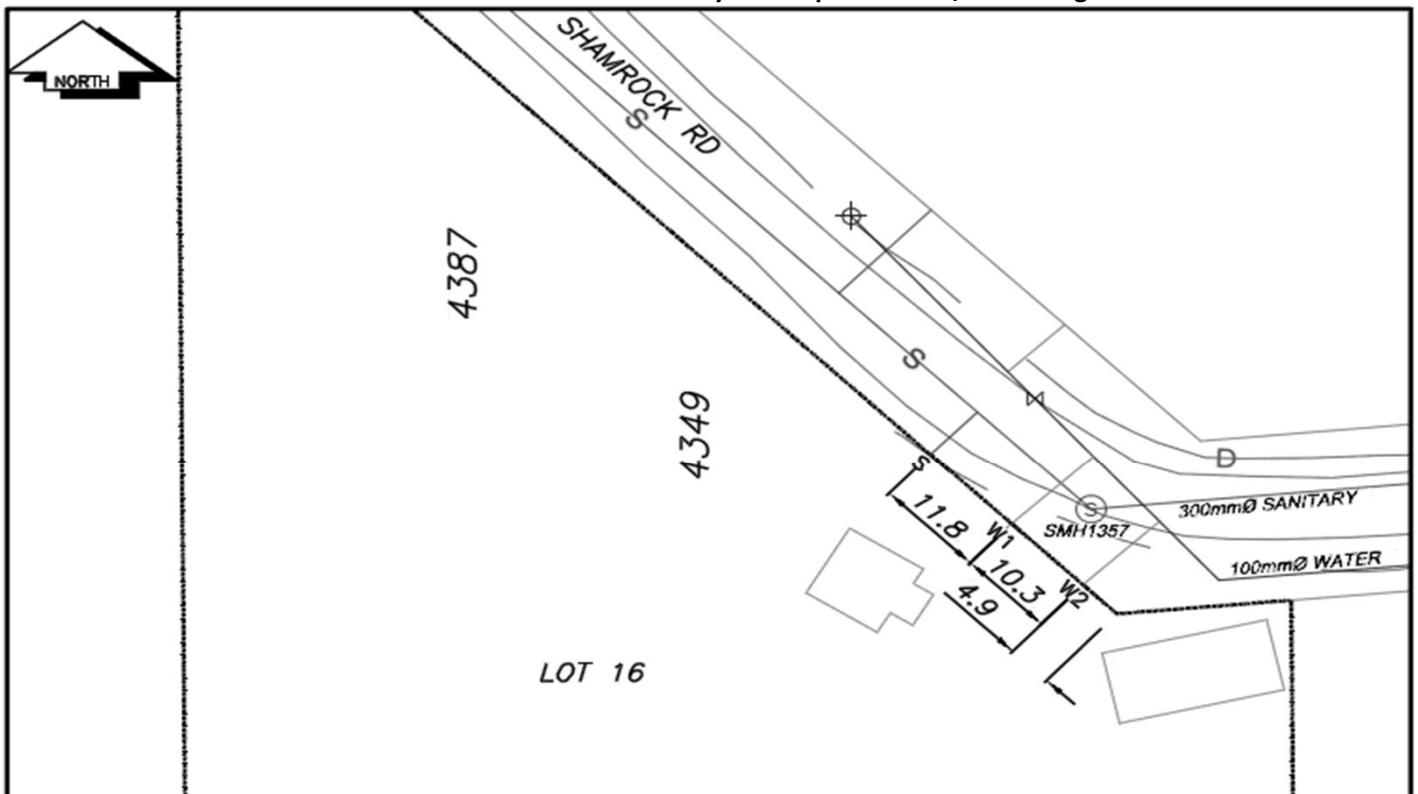

CS ^o CURB STOP	—S— WATER SERVICE	—o— STORM SERVICE
CO ^o CLEAN OUT	- - - - - SANITARY SERVICE	—G— GAS
⊗ WATER VALVE	⊕ FIRE HYDRANT	- - - - - ENCUMBRANCE

NOT TO SCALE