



City of Prince George History Sheet

PID:	013984128
SD/MU:	
WO:	5004402

Civic Address: 1233 Porter Ave

Legal Description: Lot: 2 PCL P REM District Lot: 931 Plan: 1810


Service Type	Diameter (mm)	Material	Invert Elev at main (m)	Invert Elev at property line (m)	Invert Depth at service end (m)	Distance into property (m)	Installation Date
Sanitary (S1)	100mm	PVC	-	-	-	-	December 1982
Sanitary (2)	100mm	PVC	-	-	-	-	December 1982
Water (W1)	20mm	Copper	-	-	-	-	March 2017
Water (W2)	20mm	Copper	-	-	-	-	December 1972
Water (W3)	20mm	Copper	-	-	-	-	December 1972
Storm	N/A	N/A	-	-	-	-	

Service Connection Location				Sanitary (m)	Storm (m)
Distance from downstream San MH	3469	towards upstream San MH	3401	108.58	
Distance from downstream San MH	3469	towards upstream San MH	3401	54.01	

Power	Size	Communications	Size	Cable	Size	Gas	Size
BC Hydro	-	Telus	-	Shaw	-	FortisBC	-
Overhead Service		Overhead Service		Overhead Service			

Installed by:		Survey Date:	-
Comments:	Water services located September 2016.		
	Sanitary service extrapolated from ENG card.		

NOT TO SCALE The information contained herein is for internal use only.
Not to be relied on unless confirmed by site inspection and/or investigation.

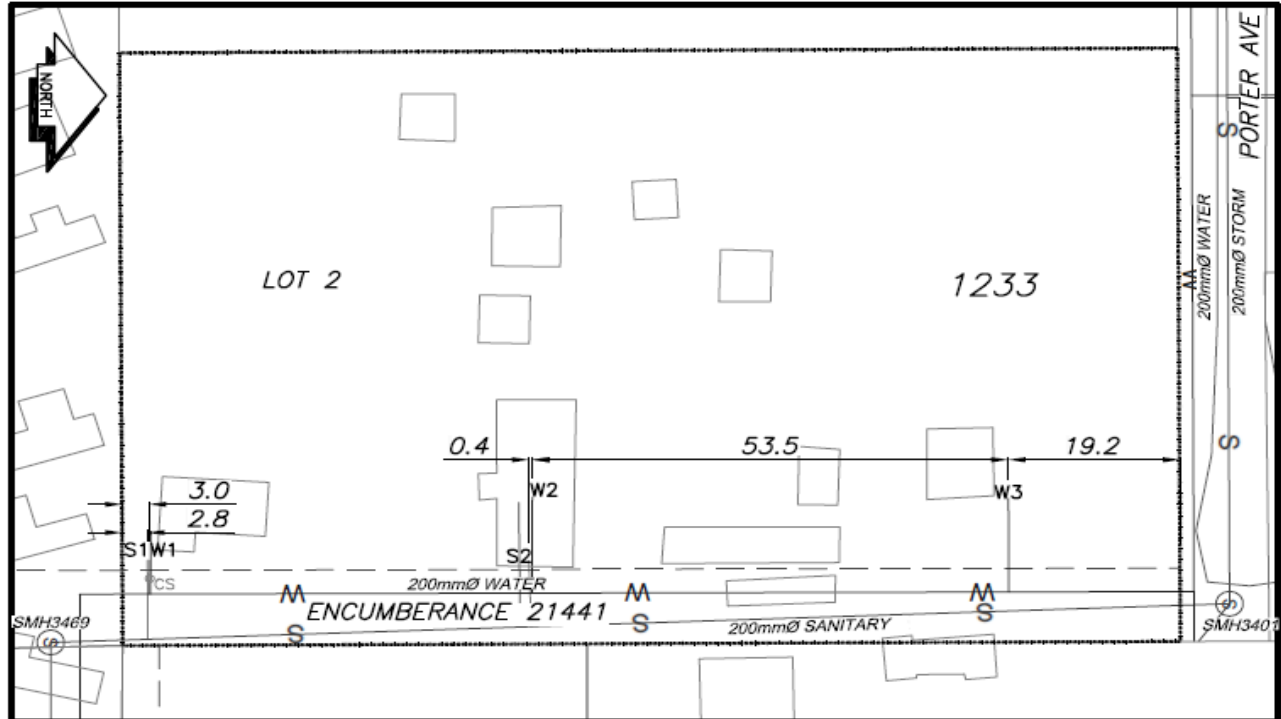

CS ^o CURB STOP	—X— WATER SERVICE	—S— STORM SERVICE
CO ^o CLEAN OUT	- - - - - SANITARY SERVICE	—G— GAS
⊗ WATER VALVE	—X— FIRE HYDRANT	- - - - - ENCUMBRANCE

NOT TO SCALE