



Lot Servicing

1039 PG PULPMILL RD 1040 PG PULPMILL RD PID: 013996029
Lot: 6, Plan: 1360, DL: 2166 REM

SERVICE	SIZE	MATERIAL	INSTALLED DATE	LOCATION	DETAILS
Water	N/A			No service available	
Sewer	N/A			No service available	

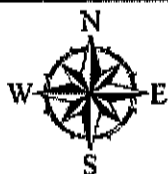

- - Sanitary
 - - Storm
 - - Water
 25 Lot Number

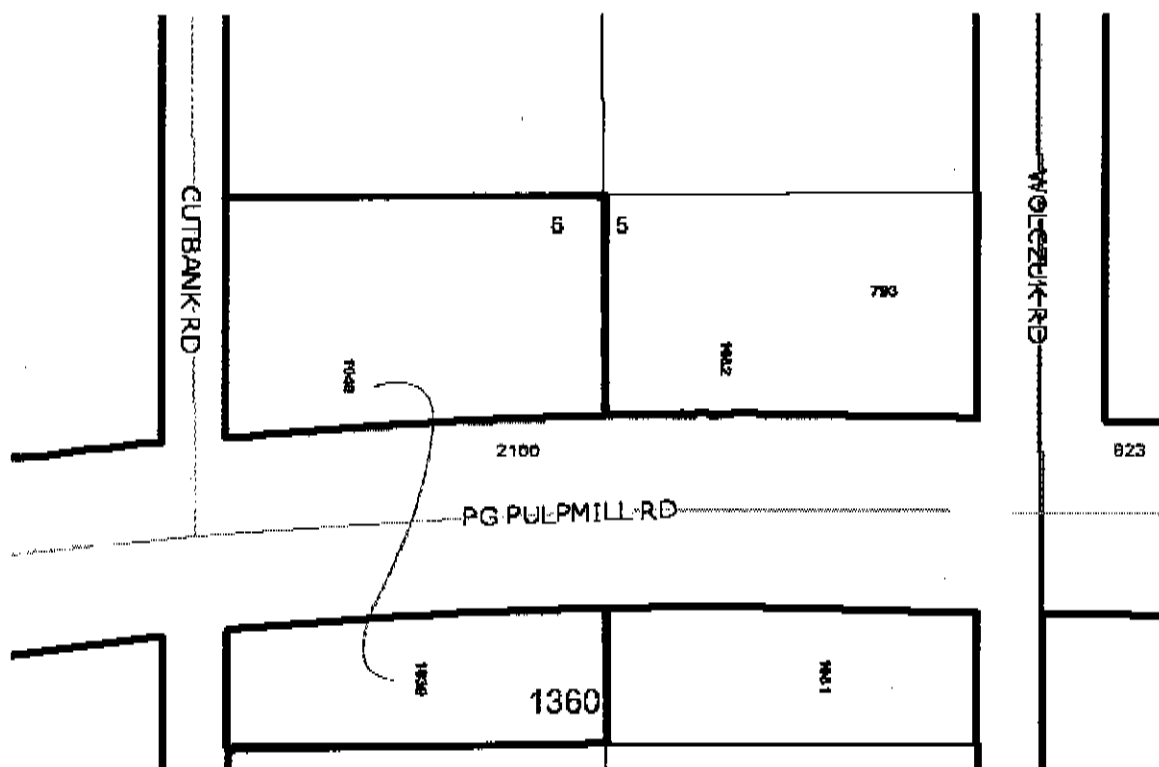

Accuracy not guaranteed unless confirmed by site inspection and/or investigation.
Connection location between main and property line only.