

## Lot Servicing

**755 CUTBANK RD**

**PID: 013996037**


**Lot: 7, Plan: 1360, DL: 2166**

SERVICE	SIZE	MATERIAL	INSTALLED DATE	LOCATION	DETAILS



- Sanitary
- - Storm
- - Water
- 25 Lot Number

Nechato Cutbanks Park

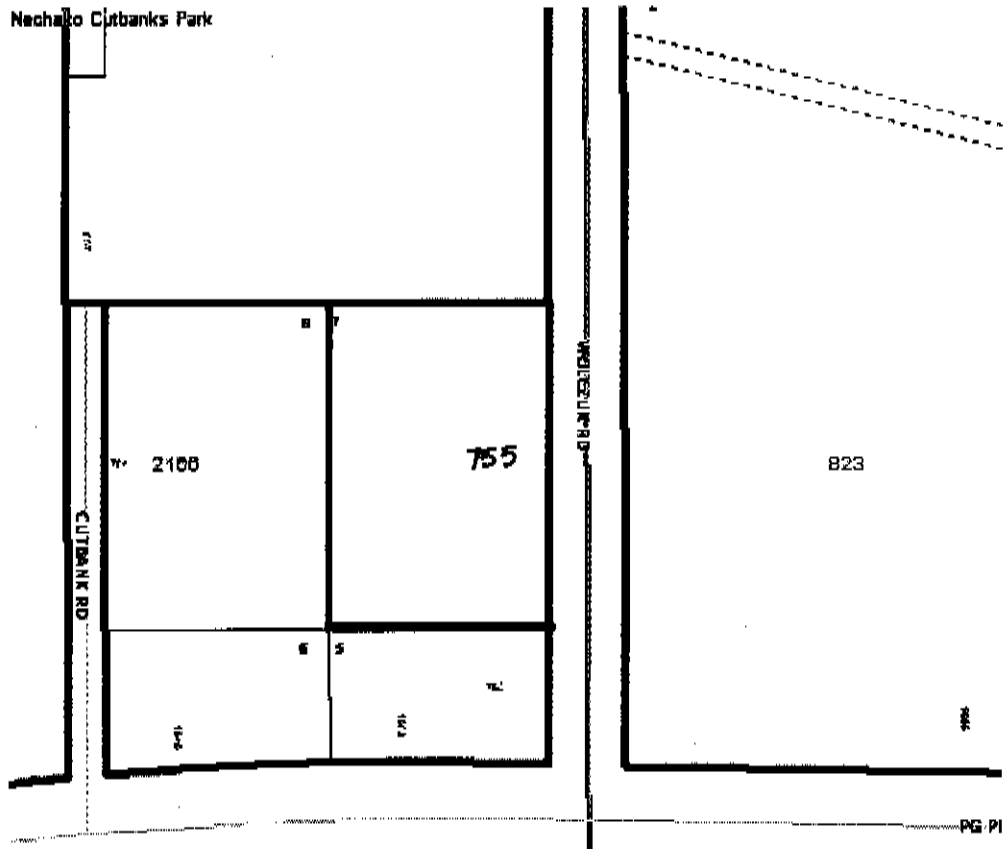

Accuracy not guaranteed unless confirmed by site inspection and/or investigation.  
Connection location between main and property line only.