

Lot Servicing

784 CUTBANK RD

PID: 013996045

Lot: 8, Plan: 1360, DL: 2166

SERVICE	SIZE	MATERIAL	INSTALLED DATE	LOCATION	DETAILS
Water	N/A			No service available	
Sewer	N/A			No service available	




— Sanitary

- Storm

- - Water

25 Lot Number

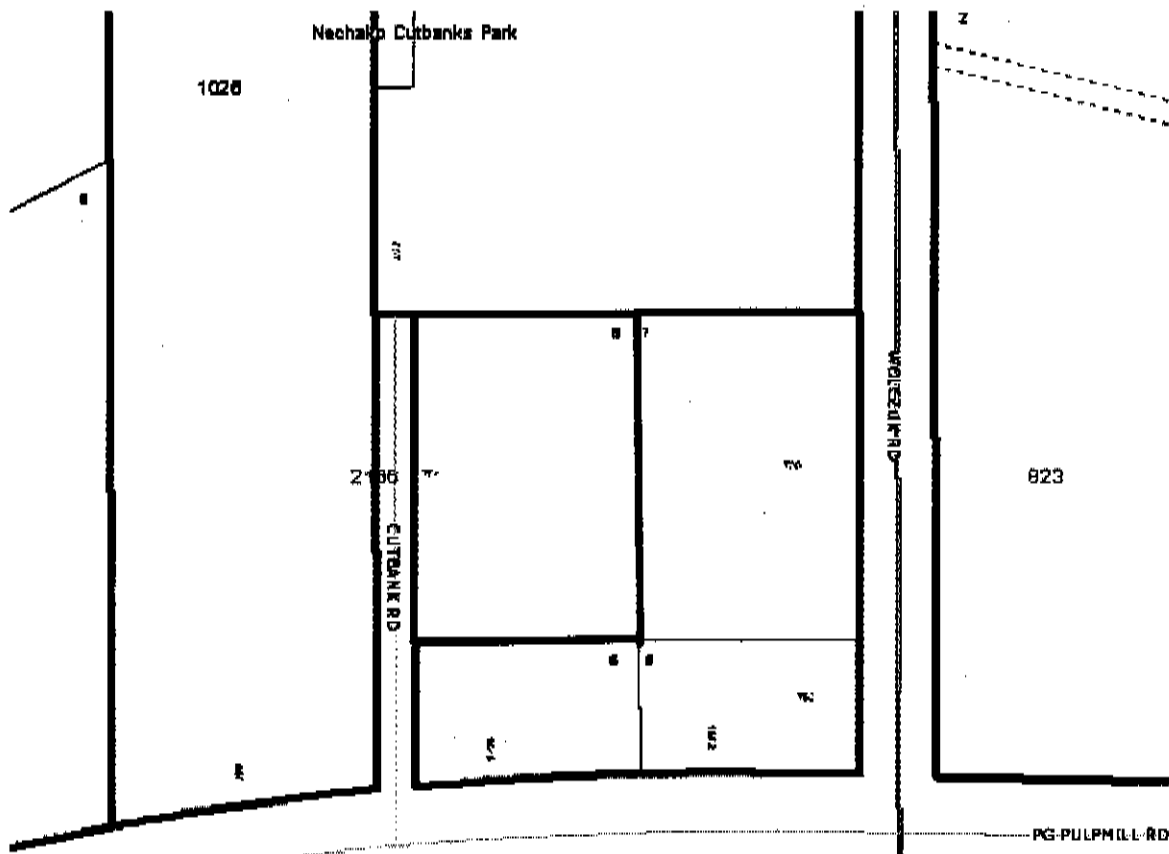

Accuracy not guaranteed unless confirmed by site inspection and/or investigation.
Connection location between main and property line only.