



City of Prince George

History Sheet

PID:	014002515
MU:	102053
WO:	96683

Civic Address: 2457 McMillan Dr

Legal Description: Lot: 153 District Lot: 4377 Plan: 1329 except Plan EPP87149


Service Type	Diameter (mm)	Material	Invert Elev at main (m)	Invert Elev at property line (m)	Invert Elev at service end (m)	Distance into property (m)	Installation Date
Sanitary	N/A	N/A	-	-	-	-	-
Water	20mm	Copper	-	-	-	-	January 2020
Storm	N/A	N/A	-	-	-	-	

Service Connection Location						Sanitary (m)	Storm (m)
Distance from downstream San MH			-	towards upstream San MH	-	-	
Distance from downstream Stm MH			-	towards upstream Stm MH	-		

Power	Size	Communications	Size	Cable	Size	Gas	Size
BC Hydro	-	Telus	-	Shaw	-	FortisBC	-
Overhead Service		Overhead Service		Overhead Service			

Installed by:	City of Prince George forces	Survey Date:	-
Comments:			

NOT TO SCALE The information contained herein is for internal use only.
Not to be relied on unless confirmed by site inspection and/or investigation.

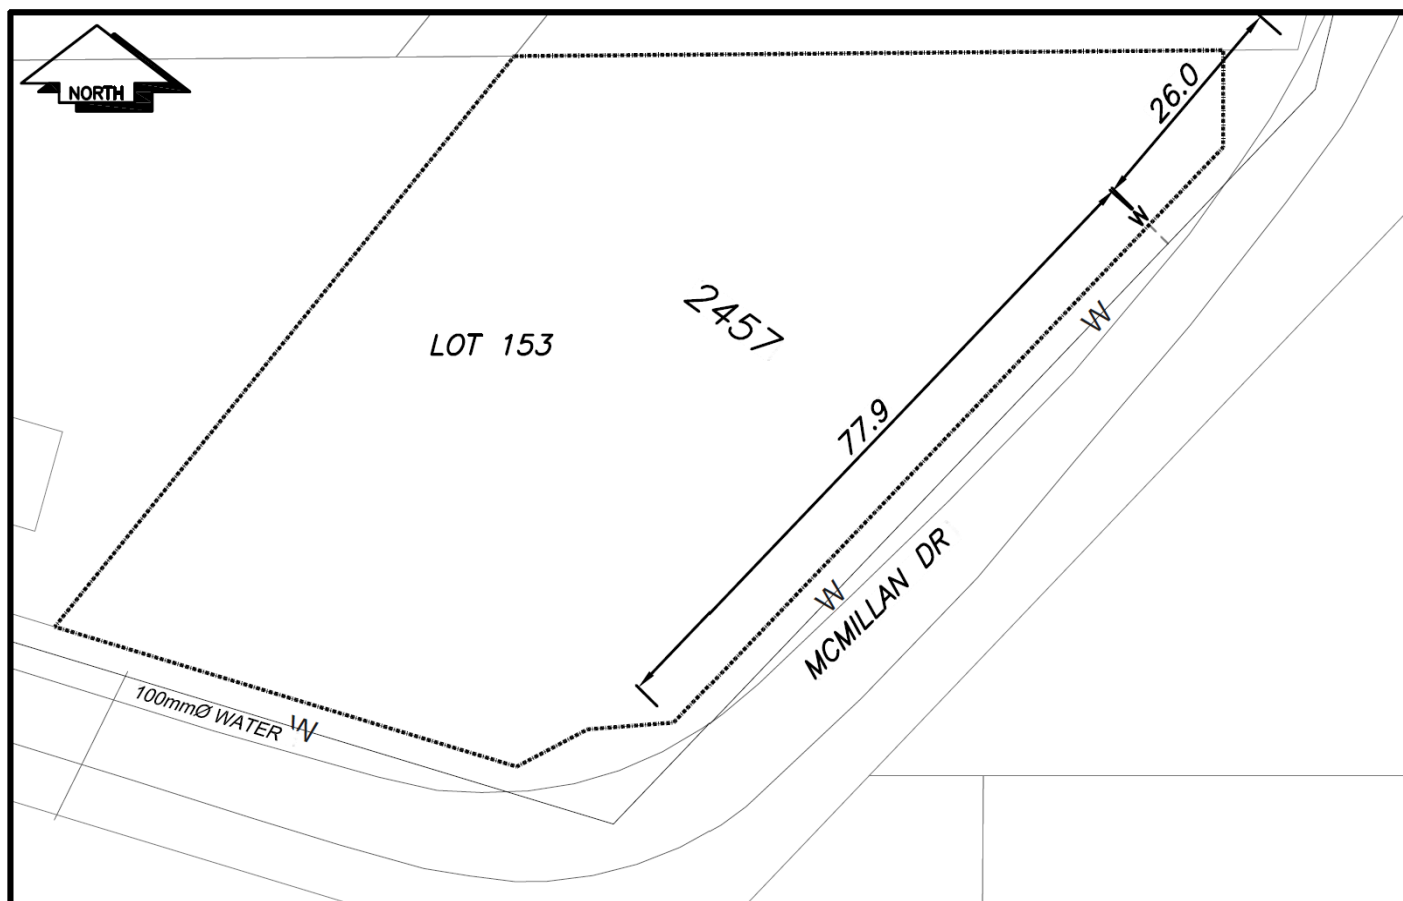

LEGEND:	CS° CURB STOP	— WATER SERVICE	— STORM SERVICE
	CO° CLEAN OUT	--- SANITARY SERVICE	— G — GAS
	⊗ WATER VALVE	⊗ FIRE HYDRANT	--- ENCUMBRANCE
		NOT TO SCALE	