

**City of Prince George
HISTORY SHEET**

014634 002

SHEET NUMBER

Roll Number

Legal: LOT'S 33 BLOCK 9 D.L. 932 PLAN 796

Address: 2263 - QUINCE ST.

Sanitary Connection: # 9147 SIZE 100 mm MATERIAL A.C. INV. 566.426 CONNECTED

Water Connection # 9147 SIZE 20 mm MATERIAL CU METER CONNECTED

Storm Connection: # SIZE MATERIAL INV. CONNECTED

Cash Receipt No's: WATER SANITARY 584 STORM

CURB FROM PROPERTY LINE 4.877 m PAVEMENT WIDTH 10.363 m

B.C. HYDRO 0/H UNDERGROUND CONNECTION



B.C. TELEPHONE 0/H UNDERGROUND CONNECTION

INLAND GAS 3.657 m FROM R

Information Sheets:

Comments:

**THE INFORMATION CONTAINED HEREIN IS FOR INTERNAL USE ONLY.
NOT TO BE RELIED UPON UNLESS CONFIRMED BY SITE INSPECTION AND/OR INVESTIGATION**

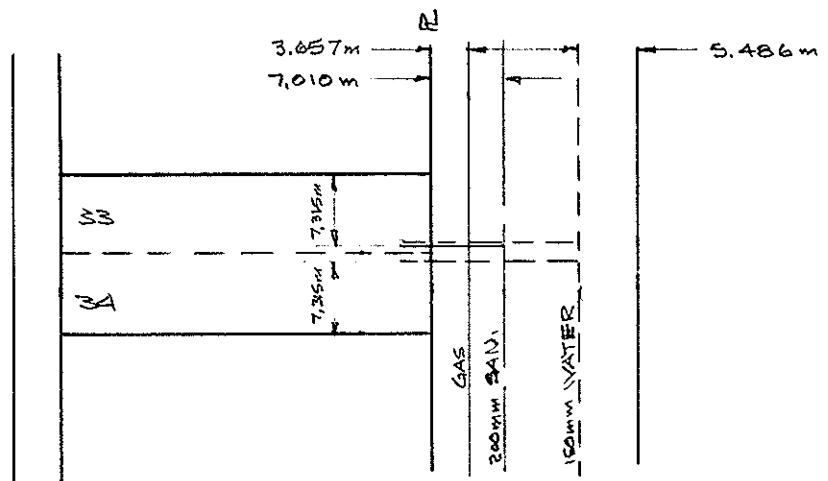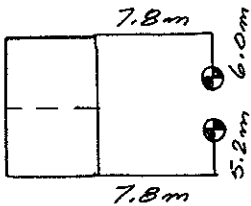

QUINCE ST.

