

City of Prince George

HISTORY SHEET

~~014034905~~

029148260

SHEET NUMBER

Roll Number

Legal: LOT'S 32 BLOCK 9 D.L. 932 PLAN 796

Address: 2257 QUINCE ST.

Sanitary Connection: #9551 SIZE 100 mm MATERIAL A.L. INV. CONNECTED

Water Connection #9551 SIZE 20 mm MATERIAL COPPER METER CONNECTED

Storm Connection: # SIZE MATERIAL INV. CONNECTED

Cash Receipt No's: WATER SANITARY STORM

CURB FROM PROPERTY LINE 4.877 m PAVEMENT WIDTH 10.363 m

B.C. HYDRO O/H UNDERGROUND CONNECTION



B.C. TELEPHONE O/H UNDERGROUND CONNECTION

INLAND GAS AS SHOWN

Information Sheets: WITH THAW WIRE;

Comments:

THE INFORMATION CONTAINED HEREIN IS FOR INTERNAL USE ONLY.
NOT TO BE RELIED UPON UNLESS CONFIRMED BY SITE INSPECTION AND/OR INVESTIGATION

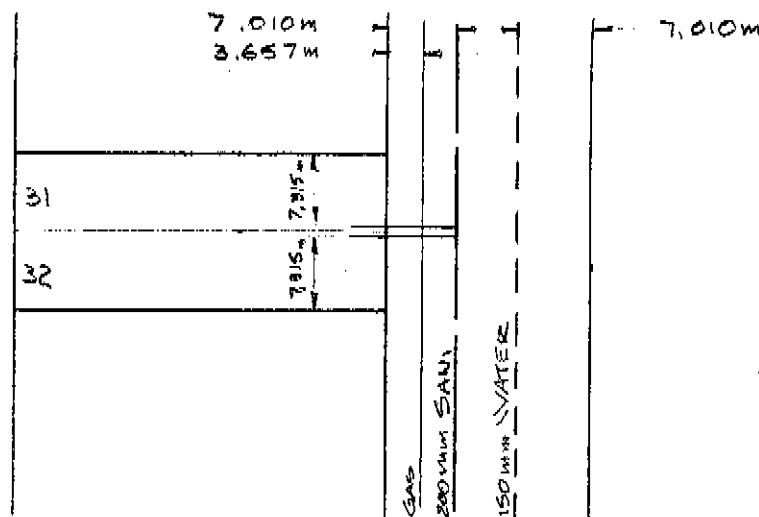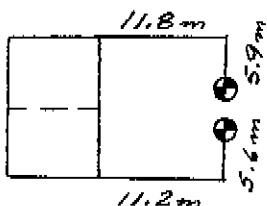

QUINCE ST.