

**City of Prince George
HISTORY SHEET**

014034981

JK

SHEET NUMBER

Roll Number

Legal: LOT'S 16 BLOCK 9 D.L. 932 PLAN 796

Address: 2370 VICTORIA ST.

Sanitary Connection: # 9157 SIZE 100mm MATERIAL A.C. INV. 567.106 CONNECTED

Water Connection # 9157 SIZE 20mm MATERIAL CU. METER CONNECTED

Storm Connection: # SIZE MATERIAL INV. CONNECTED

Cash Receipt No's: WATER SANITARY 605 STORM

CURB FROM PROPERTY LINE 2.438m PAVEMENT WIDTH 14.630m

B.C. HYDRO 0/H UNDERGROUND CONNECTION



B.C. TELEPHONE 0/H UNDERGROUND CONNECTION

INLAND GAS 3.657m FROM R.

Information Sheets:

Comments: WITH THAW WIRE.

**THE INFORMATION CONTAINED HEREIN IS FOR INTERNAL USE ONLY.
NOT TO BE RELIED UPON UNLESS CONFIRMED BY SITE INSPECTION AND/OR INVESTIGATION**

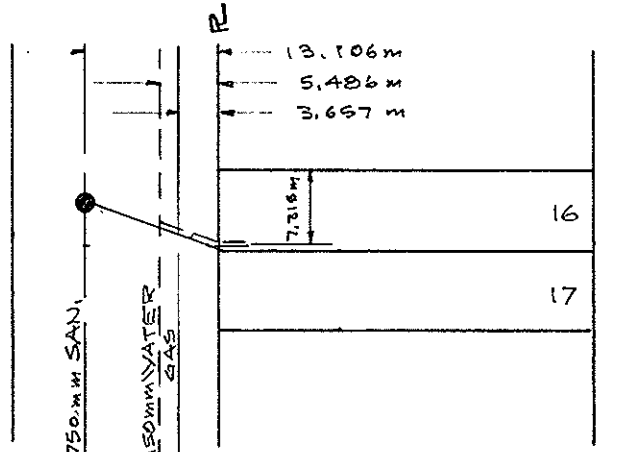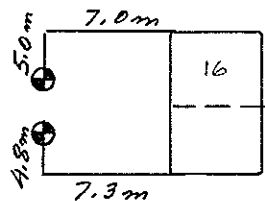

VICTORIA ST.

