

**City of Prince George  
HISTORY SHEET**

0140355 J95

JK

SHEET NUMBER

Roll Number

Legal: LOT'S 10 BLOCK 9 D.L. 932 PLAN 796

Address: 2346 VICTORIA ST.

Sanitary Connection: # 9143 SIZE 100 mm MATERIAL A.C. INV. 567.393 CONNECTED

Water Connection # 9143 SIZE 20 mm MATERIAL C.U. METER CONNECTED

Storm Connection: # SIZE MATERIAL INV. CONNECTED

Cash Receipt No's: WATER SANITARY 578 STORM

CURB FROM PROPERTY LINE 2.438 m PAVEMENT WIDTH 14.630 m

B.C. HYDRO O/H UNDERGROUND CONNECTION



B.C. TELEPHONE O/H UNDERGROUND CONNECTION

INLAND GAS 3.657 m FROM R.

Information Sheets:

Comments: WITH THAW WIRE.

**THE INFORMATION CONTAINED HEREIN IS FOR INTERNAL USE ONLY.  
NOT TO BE RELIED UPON UNLESS CONFIRMED BY SITE INSPECTION AND/OR INVESTIGATION**

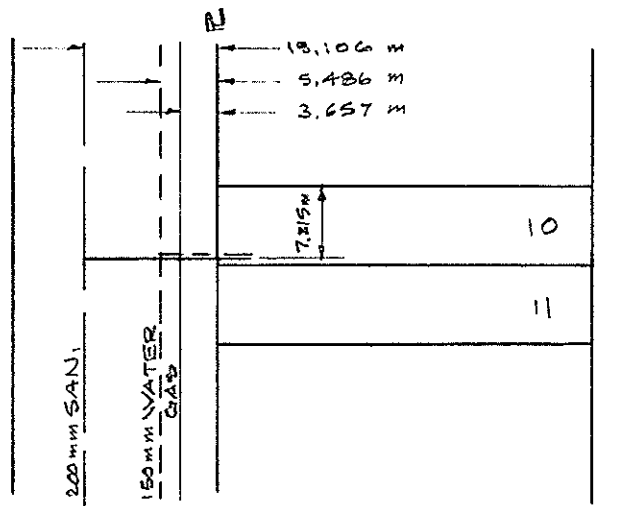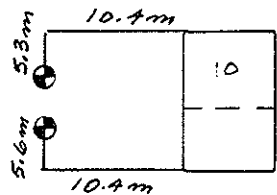

VICTORIA ST.

