

**City of Prince George  
HISTORY SHEET**


014909046  
014907046  
014069920

SHEET NUMBER	N <sup>o</sup> 2357	Roll Number
Legal:	LOT'S <b>PARCEL A (T24261)</b> <b>PARCEL A (12)</b> BLOCK 23	D.L. 937 PLAN 757
Address:	689 JOHNSON STREET	
Sanitary Connection: #	1656	SIZE MATERIAL INV. CONNECTED
Water Connection #	977	SIZE 19mm MATERIAL METER CONNECTED
Storm Connection: #		SIZE MATERIAL INV. CONNECTED
Cash Receipt No's:	WATER	SANITARY 2885 STORM
CURB FROM PROPERTY LINE	4.817m	PAVEMENT WIDTH
B.C. HYDRO	OVERHEAD	UNDERGROUND CONNECTION
B.C. TELEPHONE	OVERHEAD	UNDERGROUND CONNECTION
INLAND GAS	as shown	

**Information Sheets:**

**Comments:**

The information contained herein is for internal use only. Not to be relied upon unless confirmed by site inspection and/or investigation.

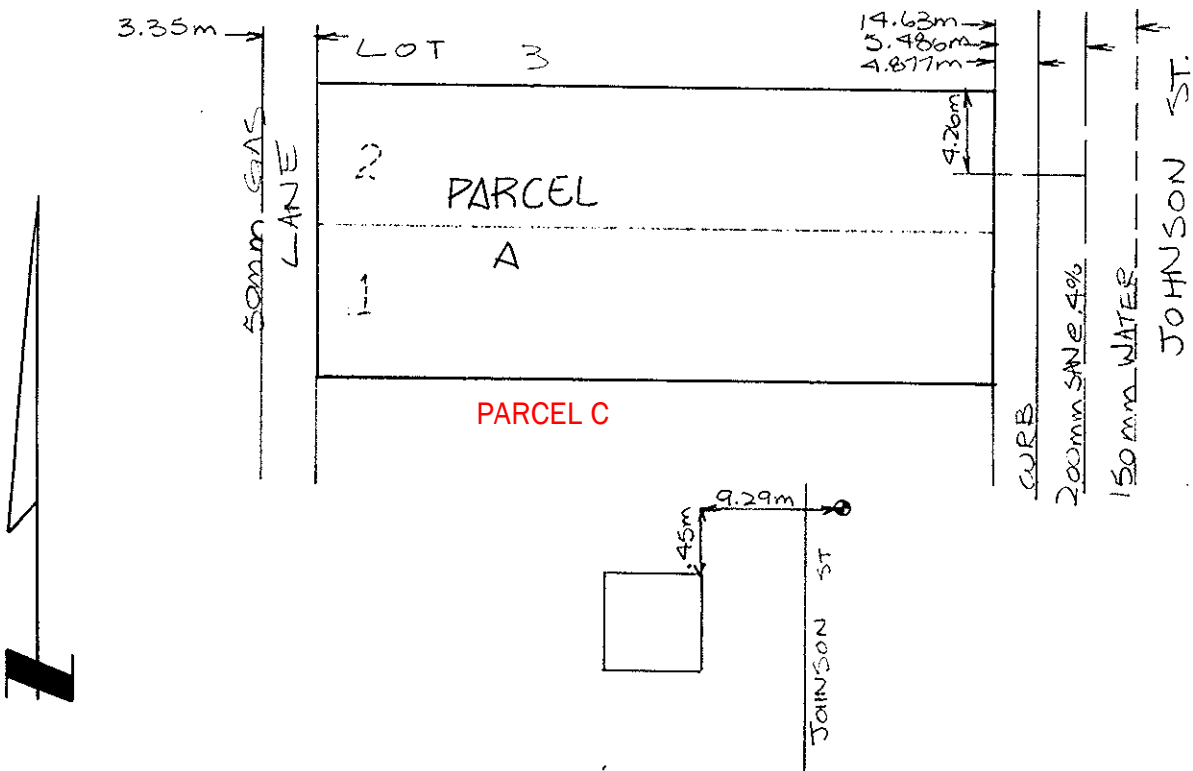

# REPORT TO RECORDS

## WATER SERVICE INFORMATION

Lot No. \_\_\_\_\_ Block \_\_\_\_\_ D.L. \_\_\_\_\_


Address 689 Johnson.

Size of Connection  1/2"  3/4"  Other \_\_\_\_\_

Type of Connection  Copper  Iron

Thaw Wire  Yes  No

### LOCATION SKETCH

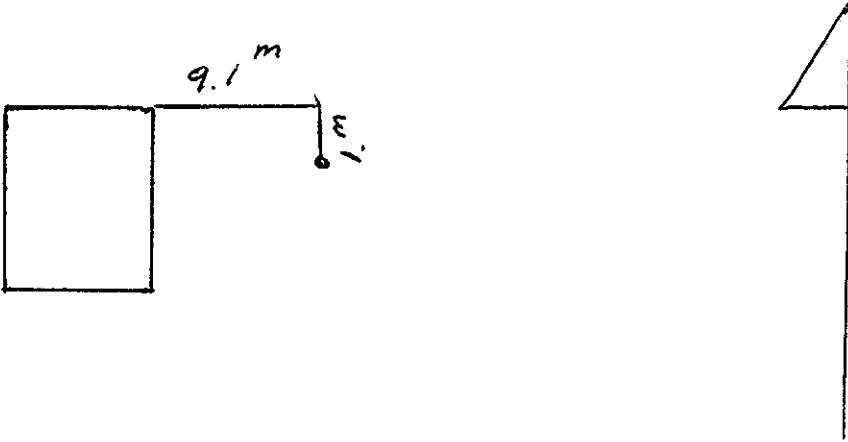

Field Location By G. Clayton Date 6/8/92

Checked by: \_\_\_\_\_