
## **City of Prince George** HISTORY SHEET

SHEET NUMBER Nº	HISTORY SHEET					014084651			
	2038				Roll Number		660		
Legal: LOT'S	7-8	BLOCK	60	D.L.	937	PLAN	752		
Address:	443	APNEY	STREET						
Sanitary Connection: #	948	SIZE	MATERIAL		INV.		CONNECTED		
Water Connection #	1157	SIZE	an MATERIAL	CU.	METER		CONNECTED		
Storm Connection: #		SIZE	MATERIAL		INV.		CONNECTED		
Cash Receipt No's:	WATER		SANITARY			STORM			
CURB FROM PROPERTY LINE	PAVEMENT WIDTH								
B.C. HYDRO			UNDERGROU	ND CONNE	CTION				
B.C. TELEPHONE	UNDERGROUND CONNECTION								
INLAND GAS									
Information Sheets:	The information contained herein is for								
Comments:	internal use only. Not to be relied upon unless confirmed by site inspection and/or								
			investigation.		•				
		······	•	<del></del>					
		SITI	E PLAN	N.T.S.	·				

PLAN

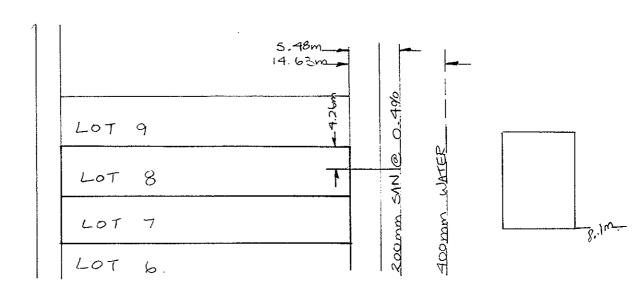

N.T.S.