
City of Prince George HISTORY SHEET

			HISTORY SHEET		<i></i>		314084651
SHEET NUMBER Nº	2038				Ro	II Number	660
Legal: LOT'S	7.8	ВLОСК	60	D.L.	931	PLAN	752
Address:	443	APNEY	STREET	·			
Sanitary Connection: #	948	SIZE	MATERIAL		INV.		CONNECTED
Water Connection #	1157	SIZE	A MATERIAL	<u>CU.</u>	METER		CONNECTED
Storm Connection: #		SIZE	MATERIAL		INV.		CONNECTED
Cash Receipt No's:	WATER		ŞANITARY	··········		STORM	
CURB FROM PROPERTY LINE	PAVEMENT WIDTH						
B.C. HYDRO	UNDERGROUND CONNECTION						
B.C. TELEPHONE	UNDERGROUND CONNECTION						
INLAND GAS	·						
Information Sheets:			The information				and the contract of the contra
Comments:			internal use o unless confirm investigation.				
			•				

PLAN

SITE

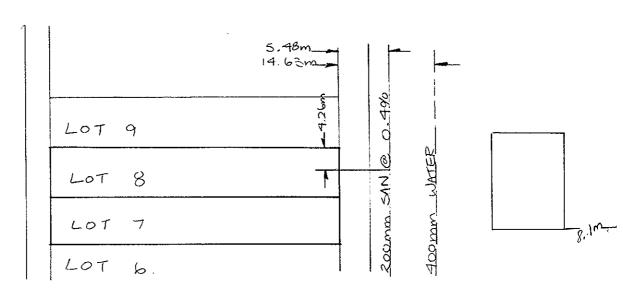

N.T.S.