



City of Prince George

History Sheet

PID:	014145201
	014145171
MU:	101844
WO:	91776

Civic Address: 282 Douglas St

Legal Description: Lot: 23, 24 Block: 90 District Lot: 937 Plan: 752


Service Type	Diameter (mm)	Material	Invert Elev at main (m)	Invert Elev at property line (m)	Invert Depth at service end (m)	Distance into property (m)	Installation Date
Sanitary	100mm	PVC	-	-	-	-	July 2017
Water	20mm	Copper	-	-	-	-	July 2017
Storm	N/A	N/A	-	-	-	-	

Service Connection Location				Sanitary (m)	Storm (m)
Distance from downstream San MH	1637	towards upstream San MH	2521	25.26	
Distance from downstream Stm MH	-	towards upstream Stm MH	-		

Power	Size	Communications	Size	Cable	Size	Gas	Size
BC Hydro	-	Telus	-	Shaw	-	FortisBC	-
Overhead Service		Overhead Service		Overhead Service			

Installed by:		Survey Date:	-
Comments:	Water and Sanitary location confirmed June 13, 2018 by UTOPS		

NOT TO SCALE The information contained herein is for internal use only.
Not to be relied on unless confirmed by site inspection and/or investigation.

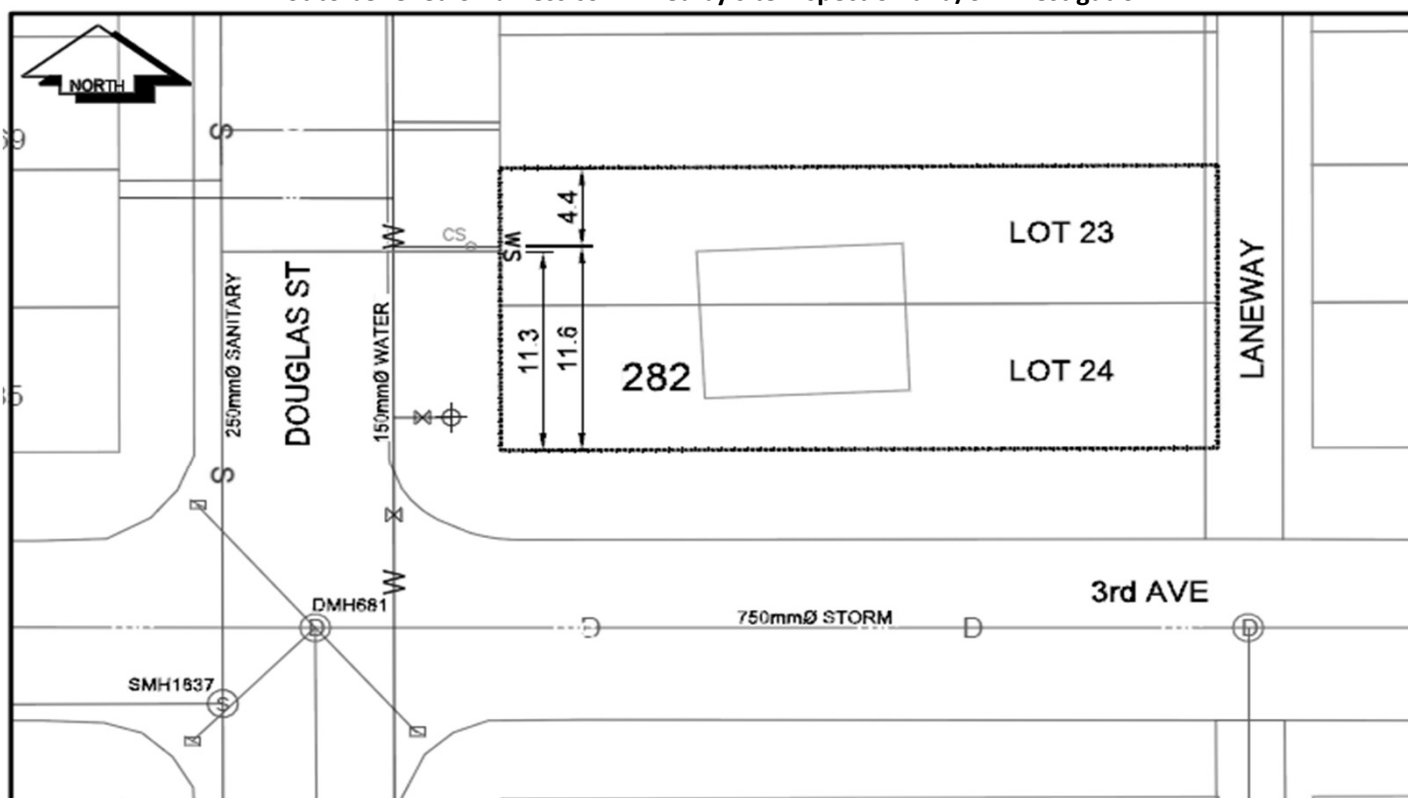

CS	CURB STOP	W	WATER SERVICE	SC	STORM SERVICE
CO	CLEAN OUT	S	SANITARY SERVICE	G	GAS
WV	WATER VALVE	FH	FIRE HYDRANT	---	ENCUMBRANCE

NOT TO SCALE