

City of Prince George
HISTORY SHEET

SHEET NUMBER

PID # 014/45 362

Legal: LOTS AMD-13 BLOCK 49 D.L. 937 PLAN 752

Address: 404 N. NICHOLSON ST.

Sanitary Connection: # 3235 SIZE 100 mm MATERIAL A.C. INV. 602.043 CONNECTED ✓

Water Connection: # 3275 SIZE 20 mm MATERIAL C.U. METER CONNECTED ✓

Storm Connection: # SIZE mm MATERIAL INV. CONNECTED

Cash Receipt No's: WATER SANITARY STORM

CURB FROM PROPERTY LINE 4.877 m PAVEMENT WIDTH 10.363 m

B.C. HYDRO 0/H UNDERGROUND CONNECTION


B.C. TELEPHONE 0/H UNDERGROUND CONNECTION

INLAND GAS 1.524 m FROM R IN LANE.

Information Sheets:

Comments: WITH THAI WIRE.

THE INFORMATION CONTAINED HEREIN IS FOR INTERNAL USE ONLY.
NOT TO BE RELIED UPON UNLESS CONFIRMED BY SITE INSPECTION AND/OR INVESTIGATION

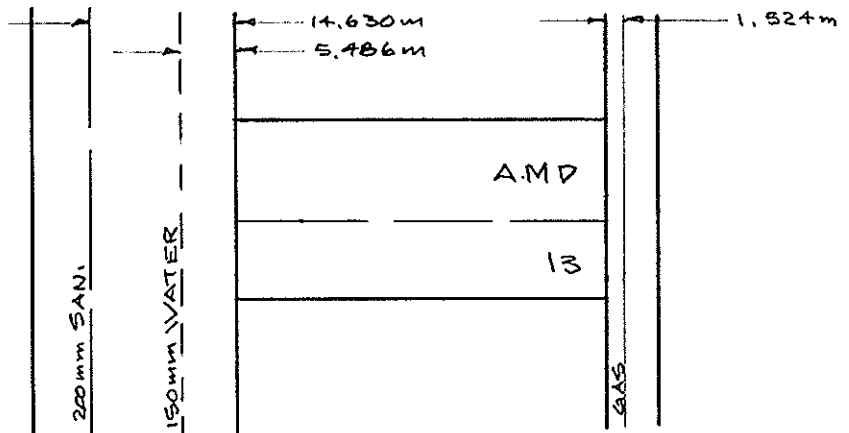

N. NICHOLSON ST.

